

CARD MUST BE TYPED

State of Kansas
NOTICE OF INTENTION TO DRILL
(see rules on reverse side)

CARD MUST BE SIGNED

Starting Date: July 12 1985
month day year

API Number 15- 059-23,973-00-00

OPERATOR: License # 5688
Name Pioneer Petroleum, Inc.
Address 116 A W. 3rd ST
City/State/Zip Ottawa, KS 66067
Contact Person George Sell
Phone 913 242 4499

App. NW NE SE
.....
(location) Sec 4 Twp 18 S, Rge 21 East
..... West

2150 Ft North from Southeast Corner of Section
1015 Ft West from Southeast Corner of Section
(Note: Locate well on Section Plat on reverse side)

CONTRACTOR: License # 6913
Name Casady Drilling Company
City/State Ottawa, KS 66067

Nearest lease or unit boundary line 330 feet.

County Franklin

Lease Name Gilchrist Well# 4WP

Domestic well within 330 feet: yes no

Municipal well within one mile: yes no

Well Drilled For: **Well Class:** **Type Equipment:**
 Oil Swd Infield Mud Rotary
 Gas Inj Pool Ext. Air Rotary
 OWWO Expl Wildcat Cable

Depth to Bottom of fresh water none feet

Lowest usable water formation 200 feet

Depth to Bottom of usable water 200 feet

Surface pipe by Alternate: 1 2

Surface pipe to be set 21 feet

Conductor pipe if any required feet

Ground surface elevation feet MSL

This Authorization Expires 1-5-86

Approved By 7-5-85

If OWWO: old well info as follows:

Operator
Well Name
Comp Date Old Total Depth
Projected Total Depth 750 feet
Projected Formation at TD
Expected Producing Formations

I certify that we will comply with K.S.A. 55-101, et seq., plus eventually plugging hole to K.C.C. specifications.

Date 7/5/85
Signature of Operator or Agent

Elaine Garham
Title

as agent

Must be filed with the K.C.C. five (5) days prior to commencing well
 This card void if drilling not started within six (6) months of date received by K.C.C.

RECEIVED
 STATE CORPORATION COMMISSION


7-5-85

Important procedures to follow:

A Regular Section of Land
 1 Mile = 5,280 Ft.

1111 05 1985

CONSERVATION DIVISION
 Wichita, Kansas

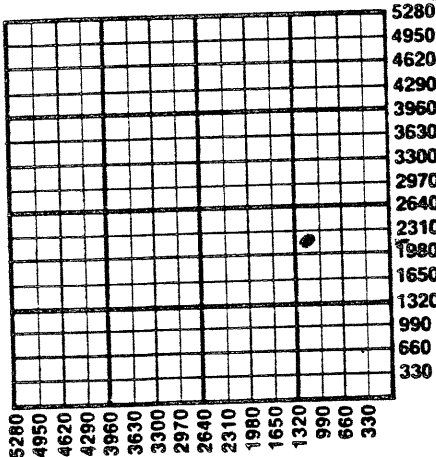

1. Notify District office before setting surface casing.
2. Set surface casing by circulating cement to the top.
3. File completion forms ACO-1 with K.C.C. within 90 days of well completion, following instructions on ACO-1, side 1, and including copies of wireline logs.
4. Notify District office 48 hours prior to old well workover or re-entry.
5. Prior to plugging, prepare a plugging plan, then obtain agreement from the appropriate district office for an approved plugging plan.
6. Submit plugging report (CP-4) to K.C.C. after plugging is completed.
7. Obtain an approved injection docket number before disposing of salt water.
8. Notify K.C.C. within 10 days when injection commences or terminates.
9. If an alternate 2 completion, cement in the production pipe from below any usable water to surface within 120 days of spud date.

State Corporation Commission of Kansas
 Conservation Division
 200 Colorado Derby Building
 Wichita, Kansas 67202
 (316) 263-3238