

CARD MUST BE TYPED

State of Kansas
NOTICE OF INTENTION TO DRILL
(see rules on reverse side)

CARD MUST BE SIGNED

Starting Date:7...2...85.....
month day year

API Number 15- 207-25,321-0000

OPERATOR: License # 9036
Name Oakridge Enterprises
Address R.R. # 1
City/State/Zip Yates Center, 66783
Contact Person Larry C. Martin
Phone 316 - 625-3334

SW\$ NE4 Sec 33 . Twp . 23 S, Rge . 15. East
(location) West

3445 Ft North from Southeast Corner of Section
1715 Ft West from Southeast Corner of Section
(Note: Locate well on Section Plat on reverse side)

CONTRACTOR: License # 9430
Name CMT Petro Resources, Inc.
City/State Canton, Mos. 63435

Nearest lease or unit boundary line 805 feet.
County Woodson
Lease Name Reinking Well# 18

Well Drilled For: Well Class: Type Equipment:
 Oil Swd Infield Mud Rotary
 Gas Inj Pool Ext. Air Rotary
 OWWO Expl Wildcat Cable

Domestic well within 330 feet : yes no
Municipal well within one mile : yes no

If OWWO: old well info as follows:
Operator
Well Name
Comp Date Old Total Depth
Projected Total Depth 1560 feet
Projected Formation at TD Mississippi
Expected Producing Formations Mississippi

Depth to Bottom of fresh water Unknown feet
Lowest usable water formation Unknown
Depth to Bottom of usable water 150 feet
Surface pipe by Alternate : 1 2
Surface pipe to be set 40 feet
Conductor pipe if any required none feet
Ground surface elevation 1060 feet MSL
This Authorization Expires 12-17-85

I certify that we will comply with K.S.A. 55-101, et seq., plus eventually plugging hole to K.C.C. specifications.
Date 6-17-85 Signature of Operator or Agent Larry C Martin Title Operator
Approved By 6-17-85 [Signature] RE

RECEIVED

STATE CORPORATION COMMISSION

Must be filed with the K.C.C. five (5) days prior to commencing well
This card void if drilling not started within six (6) months of date received by K.C.C.

JUN 17 1985


6-17-85

CONSERVATION DIVISION

Wichita, Kansas

A Regular Section of Land

1 Mile = 5,280 Ft.

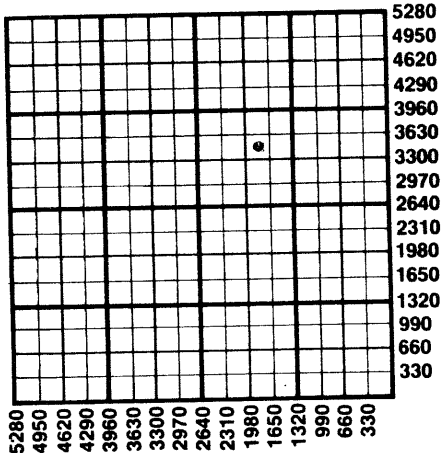

Important procedures to follow :

1. Notify District office before setting surface casing.
2. Set surface casing by circulating cement to the top.
3. File completion forms ACO-1 with K.C.C. within 90 days of well completion, following instructions on ACO-1, side 1, and including copies of wireline logs.
4. Notify District office 48 hours prior to old well workover or re-entry.
5. Prior to plugging, prepare a plugging plan, then obtain agreement from the appropriate district office for an approved plugging plan.
6. Submit plugging report (CP-4) to K.C.C. after plugging is completed.
7. Obtain an approved injection docket number before disposing of salt water.
8. Notify K.C.C. within 10 days when injection commences or terminates.
9. If an alternate 2 completion, cement in the production pipe from below any usable water to surface within 120 days of spud date.

State Corporation Commission of Kansas
 Conservation Division
 200 Colorado Derby Building
 Wichita, Kansas 67202
 (316) 263-3238