

CARD MUST BE TYPED

State of Kansas
NOTICE OF INTENTION TO DRILL
(see rules on reverse side)

CARD MUST BE SIGNED

Starting Date: 11 - 13 - 84
month day year

API Number 15- 207-25,115-0000

OPERATOR: License # 9036

NE 4 Sec 33 Twp 23 S, Rge 15 East
(location) West

Name Oakridge Enterprises

Address R.R. # 1

City/State/Zip Yates Center, Ks 66783

Contact Person Larry c. Martin

Phone 316-625-3334

2815 Ft North from Southeast Corner of Section
1715 Ft West from Southeast Corner of Section
(Note: Locate well on Section Plat on reverse side)

CONTRACTOR: License # 9430

Nearest lease or unit boundary line 175 feet.

Name CMT Petro Resources Inc.

County Woodson

City/State Canton, Mo. 63435

Lease Name Reinking Well# 13

Well Drilled For: Well Class: Type Equipment:

- Oil Swd Infield Mud Rotary
- Gas Inj Pool Ext. Air Rotary
- OWWO Expl Wildcat Cable

Domestic well within 330 feet : yes no
Municipal well within one mile : yes no

If OWWO: old well info as follows:

Operator

Well Name

Comp Date Old Total Depth

Projected Total Depth 1600 feet

Projected Formation at TD Mississippi

Expected Producing Formations Mississippi

Depth to Bottom of fresh water Unknown feet

Lowest usable water formation Unknown

Depth to Bottom of usable water 150 feet

Surface pipe by Alternate : 1 2

Surface pipe to be set 40 feet

Conductor pipe if any required none feet

Ground surface elevation 1060 feet MSL

This Authorization Expires 5-2-85
Approved By 11-1-84 *LC*


I certify that we will comply with K.S.A. 55-101, et seq., plus eventually plugging hole to K.C.C. specifications.

Date 10-31-84 Signature of Operator or Agent *Larry c. Martin* Title operator

Must be filed with the K.C.C. five (5) days prior to commencing well
 This card void if drilling not started within six (6) months of date received by K.C.C.

Important procedures to follow :

A Regular Section of Land
1 Mile = 5,280 Ft.

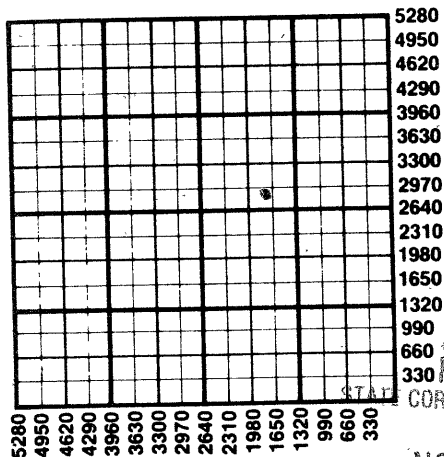

1. Notify District office before setting surface casing.
2. Set surface casing by circulating cement to the top.
3. File completion forms ACO-1 with K.C.C. within 90 days of well completion, following instructions on ACO-1, side 1, and including copies of wireline logs.
4. Notify District office 48 hours prior to old well workover or re-entry.
5. Prior to plugging, prepare a plugging plan, then obtain agreement from the appropriate district office for an approved plugging plan.
6. Submit plugging report (CP-4) to K.C.C. after plugging is completed.
7. Obtain an approved injection docket number before disposing of salt water.
8. Notify K.C.C. within 10 days when injection commences or terminates.
9. If an alternate 2 completion, cement in the production pipe from below any usable water to surface within 120 days of spud date.

RECEIVED
 CORPORATION COMMISSION

State Corporation Commission of Kansas
 Conservation Division
 200 Colorado Derby Building
 Wichita, Kansas 67202
 (316) 263-3238

NOV 01 1964
 16-1-84
 CONSERVATION DIVISION
 Wichita, Kansas