

CARD MUST BE TYPED

State of Kansas
NOTICE OF INTENTION TO DRILL
(see rules on reverse side)

CARD MUST BE SIGNED

Starting Date: 10 17 1984
month day year 2.15

OPERATOR: License # 5935
Name Mark L. Haas Oil Co.
Address Box 288
City/State/Zip Yates Center, Ks 66783
Contact Person Mark Haas
Phone 316 625 2171

CONTRACTOR: License # 7721
Name Coconut Drilling Co.
City/State Yates Center, Ks 66783

Well Drilled For:		Well Class:	Type Equipment:
☒ Oil	☐ Swd	☒ Infield	☒ Mud Rotary
☐ Gas	☐ Inj	☐ Pool Ext.	☐ Air Rotary
☐ OWWO	☐ Expl	☐ Wildcat	☐ Cable

If OWWO: old well info as follows:

Operator
Well Name
Comp Date Old Total Depth
Projected Total Depth 1500 feet
Projected Formation at TD Mississippian
Expected Producing Formations

I certify that we will comply with K.S.A. 55-101, et seq., plus eventually plugging hole to K.C.C. specifications.

Date 10/15/84 Signature of Operator or Agent

E. Barkham

Title as agent

API Number 15- 207-25,089-00 00

E/2.SW/4... Sec 34. Twp 23. S, Rge 15. ☒ East
(location) ☐ West

165
Ft North from Southeast Corner of Section
3795. Ft West from Southeast Corner of Section
(Note: Locate well on Section Plat on reverse side)

Nearest lease or unit boundary line 165 feet.

County Woodson

Lease Name Switzer Well# 2-H

Domestic well within 330 feet: ☐ yes ☒ no

Municipal well within one mile: ☐ yes ☒ no

Depth to Bottom of fresh water 20 feet

Lowest usable water formation

Depth to Bottom of usable water 150 feet

Surface pipe by Alternate: 1 ☐ 2 ☒

Surface pipe to be set 42 20 feet

Conductor pipe if any required feet

Ground surface elevation feet MSL

This Authorization Expires 1-15-85

Approved By 10-15-84 *R.*

Must be filed with the K.C.C. five (5) days prior to commencing well
This card void if drilling not started within six (6) months of date received by K.C.C.

Wichita, Kansas
CONSERVATION DIVISION


OCT 15 1984

16-15-84

Important procedures to follow:

1. Notify District office before setting surface casing.
2. Set surface casing by circulating cement to the top.
3. File completion forms ACO-1 with K.C.C. within 90 days of well completion, following instructions on ACO-1, side 1, and including copies of wireline logs.
4. Notify District office 48 hours prior to old well workover or re-entry.
5. Prior to plugging, prepare a plugging plan, then obtain agreement from the appropriate district office for an approved plugging plan.
6. Submit plugging report (CP-4) to K.C.C. after plugging is completed.
7. Obtain an approved injection docket number before disposing of salt water.
8. Notify K.C.C. within 10 days when injection commences or terminates.
9. If an alternate 2 completion, cement in the production pipe from below any usable water to surface within 120 days of spud date.

A Regular Section of Land
1 Mile 5 280 Ft.

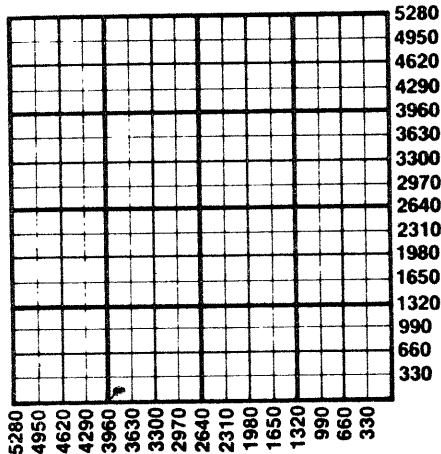

State Corporation Commission of Kansas
Conservation Division
200 Colorado Derby Building
Wichita, Kansas 67202
(316) 263-3238