

CARD MUST BE TYPED

NOTICE OF INTENTION TO DRILL

State of Kansas
(see rules on reverse side)

CORRECTION
CARD MUST BE SIGNED

Starting Date: 8 month 1 day 85 year

API Number 15- 207-25,351 00-00

OPERATOR: License # 6474
Name Richard ~~Oil~~ Oil Co
Address P.O. Box 814
City/State/Zip Chanute, KS 66720
Contact Person Mark Richard
Phone 431-2080

NW/4 (location) Sec 34 Twp 23 S, Rge 15 East West

~~3795~~ 3795 Ft North from Southeast Corner of Section 5115
Ft West from Southeast Corner of Section
(Note: Locate well on Section Plat on reverse side)

CONTRACTOR: License # 6010
Name John T. Davis Davis Drilling Co.
City/State Yates Center, KS

Nearest lease or unit boundary line 165 feet.

County Woodson

Lease Name Weston Well # 116

Domestic well within 330 feet: yes no

Municipal well within one mile: yes no

Well Drilled For: Well Class: Type Equipment:
 Oil Swd Infield Mud Rotary
 Gas Inj Pool Ext. Air Rotary
 OWWO Expl Wildcat Cable

Depth to Bottom of fresh water none 240 feet

Lowest usable water formation none

Depth to Bottom of usable water 150 feet

Surface pipe by Alternate: 1 2

Surface pipe to be set 40' feet

Conductor pipe if any required

Ground surface elevation

This Authorization Expires 1-29-86

Approved By 7-29-85

If OWWO: old well info as follows:
Operator
Well Name
Comp Date Old Total Depth
Projected Total Depth 1600 feet
Projected Formation at TD Mississippian
Expected Producing Formations Miss-Squirrel


I certify that we will comply with K.S.A. 55-101, et seq., plus eventually plugging hole to K.C.C. specifications twice

Date 7-25-85 Signature of Operator or Agent Mark R. [Signature] Title Richard Eng. Partner REH FORKONE #3

Must be filed with the K.C.C. five (5) days prior to commencing well
This card void if drilling not started within six (6) months of date received by K.C.C.

7-29-85
RECEIVED
STATE CORPORATION COMMISSION
JUL 29 1985
CONSERVATION DIVISION
Wichita, Kansas

A Regular Section of Land
1 Mile = 5,280 Ft.

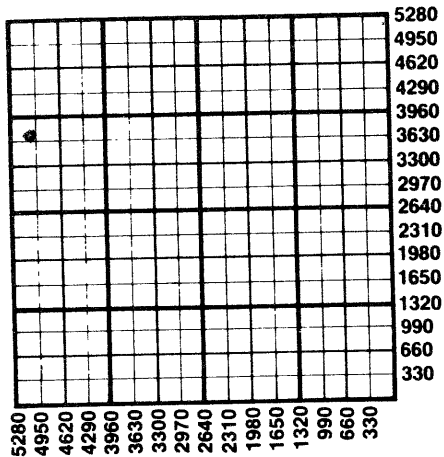

- Important procedures to follow:**
1. Notify District office before setting surface casing.
 2. Set surface casing by circulating cement to the top.
 3. File completion forms ACO-1 with K.C.C. within 90 days of well completion, following instructions on ACO-1, side 1, and including copies of wireline logs.
 4. Notify District office 48 hours prior to old well workover or re-entry.
 5. Prior to plugging, prepare a plugging plan, then obtain agreement from the appropriate district office for an approved plugging plan.
 6. Submit plugging report (CP-4) to K.C.C. after plugging is completed.
 7. Obtain an approved injection docket number before disposing of salt water.
 8. Notify K.C.C. within 10 days when injection commences or terminates.
 9. If an alternate 2 completion, cement in the production pipe from below any usable water to surface within 120 days of spud date.

State Corporation Commission of Kansas
Conservation Division
200 Colorado Derby Building
Wichita, Kansas 67202
(316) 263-3238