

CARD MUST BE TYPED

State of Kansas NOTICE OF INTENTION TO DRILL

(see rules on reverse side)

CARD MUST BE SIGNED

Starting Date: 7 10 1985
month day year

OPERATOR: License # 9864
Name William A. Johnson, III
Address 4100 Adams, Suite D-211
City/State/Zip Bartlesville, OK 74006
Contact Person William A. Johnson III
Phone (918) 333-8670

CONTRACTOR: License #
Name Unknown
City/State

Well Drilled For:	Well Class:	Type Equipment:
☒ Oil ☐ Swd	☐ Infield	☒ Mud Rotary
☐ Gas ☐ Inj	☐ Pool Ext.	☐ Air Rotary
☐ OWWO ☐ Expl	☒ Wildcat	☐ Cable

If OWWO: old well info as follows:

Operator
Well Name
Comp Date Old Total Depth
Projected Total Depth 1800 feet
Projected Formation at TD Mississippian
Expected Producing Formations

I certify that we will comply with K.S.A. 55-101, et seq., plus eventually plugging hole to K.C.C. specifications.

Date 7/8/85
Signature of Operator or Agent

Susan Arnold
Title

As Agent

API Number 15- 207.25, 339-00-00

NE NW NW Sec 34 Twp 23 S, Rge 15 ☒ East
(location) ☐ West

4785

4224

Ft North from Southeast Corner of Section

Ft West from Southeast Corner of Section

(Note: Locate well on Section Plat on reverse side)

Nearest lease or unit boundary line 495 feet.

County Woodson

Lease Name Greene Well# 1

Domestic well within 330 feet : ☐ yes ☒ no

Municipal well within one mile : ☐ yes ☒ no

Depth to Bottom of fresh water 50 feet

Lowest usable water formation

Depth to Bottom of usable water 150 feet

Surface pipe by Alternate : 1 ☐ 2 ☒ *Yes*

Surface pipe to be set *Yes* feet

Conductor pipe if any required feet

Ground surface elevation feet MSL

This Authorization Expires 7-8-86

Approved By *[Signature]*
7-8-85

RCH for KDH

58-8-L


RECEIVED
STATE CORPORATION COMMISSION

Important procedures to follow:

A Regular Section of Land
1 Mile = 5,280 Ft.

JUL 08 1985

Conservation Division
Wichita, Kansas

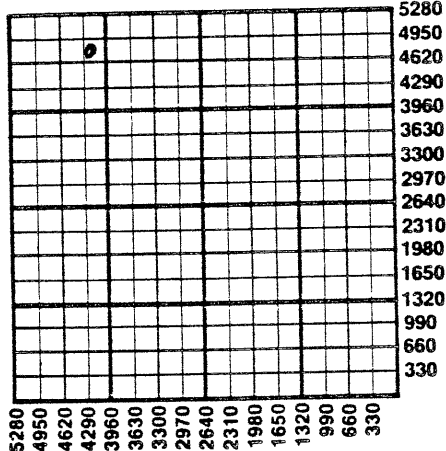

1. Notify District office before setting surface casing.
2. Set surface casing by circulating cement to the top.
3. File completion forms ACO-1 with K.C.C. within 90 days of well completion, following instructions on ACO-1, side 1, and including copies of wireline logs.
4. Notify District office 48 hours prior to old well workover or re-entry.
5. Prior to plugging, prepare a plugging plan, then obtain agreement from the appropriate district office for an approved plugging plan.
6. Submit plugging report (CP-4) to K.C.C. after plugging is completed.
7. Obtain an approved injection docket number before disposing of salt water.
8. Notify K.C.C. within 10 days when injection commences or terminates.
9. If an alternate 2 completion, cement in the production pipe from below any usable water to surface within 120 days of spud date.

State Corporation Commission of Kansas
Conservation Division
200 Colorado Derby Building
Wichita, Kansas 67202
(316) 263-3238