

For KCC Use:
Effective Date: 8-22-06
District #: 3
SGA? Yes No

KANSAS CORPORATION COMMISSION
OIL & GAS CONSERVATION DIVISION

Form C-1
December 2002

Form must be Typed
Form must be Signed
All blanks must be Filled

NOTICE OF INTENT TO DRILL

Must be approved by KCC five (5) days prior to commencing well

Expected Spud Date 8 23 06
month day year

OPERATOR: License# 6168
Name: Lester Scheuneman
Address: 27800 Pleasant Valley Rd.
City/State/Zip: Wellsville, Ks. 66092
Contact Person: Lester Scheuneman
Phone: (785) 883-4621

CONTRACTOR: License# 4339
Name: Dale Jackson

| | | |
|--|---|--|
| Well Drilled For: | Well Class: | Type Equipment: |
| <input checked="" type="checkbox"/> Oil | <input checked="" type="checkbox"/> Infield | <input checked="" type="checkbox"/> Mud Rotary |
| <input type="checkbox"/> Gas | <input type="checkbox"/> Pool Ext. | <input type="checkbox"/> Air Rotary |
| <input type="checkbox"/> OWWO | <input type="checkbox"/> Wildcat | <input type="checkbox"/> Cable |
| <input type="checkbox"/> Seismic; # of Holes | <input type="checkbox"/> Other | |
| <input type="checkbox"/> Other | | |

If OWWO: old well information as follows:
Operator: _____
Well Name: _____
Original Completion Date: _____ Original Total Depth: _____
Directional, Deviated or Horizontal wellbore? Yes No
If Yes, true vertical depth: _____
Bottom Hole Location: _____
KCC DKT #: _____

Spot East
NE - NW - SW Sec. 14 Twp. 17 S. R. 21 West
2142 feet from N / S Line of Section
4023 feet from E / W Line of Section
Is SECTION Regular Irregular?

(Note: Locate well on the Section Plat on reverse side)

County: Miami
Lease Name: Boyscout Well #: A-5
Field Name: Rantaul
Is this a Prorated / Spaced Field? Yes No
Target Formation(s): Squirrel
Nearest Lease or unit boundary: 165
Ground Surface Elevation: N.A. feet MSL
Water well within one-quarter mile: Yes No
Public water supply well within one mile: Yes No
Depth to bottom of fresh water: 20
Depth to bottom of usable water: 180
Surface Pipe by Alternate: 1 2
Length of Surface Pipe Planned to be set: 20
Length of Conductor Pipe required: 20
Projected Total Depth: 750
Formation at Total Depth: Squirrel
Water Source for Drilling Operations:
 Well Farm Pond Other _____
DWR Permit #: _____

(Note: Apply for Permit with DWR)

Will Cores be taken? Yes No
If Yes, proposed zone: _____

AFFIDAVIT

The undersigned hereby affirms that the drilling, completion and eventual plugging of this well will comply with K.S.A. 55 et. seq.
It is agreed that the following minimum requirements will be met:

1. Notify the appropriate district office **prior** to spudding of well;
2. A copy of the approved notice of intent to drill **shall be** posted on each drilling rig;
3. The minimum amount of surface pipe as specified below **shall be set** by circulating cement to the top; in all cases surface pipe **shall be set** through all unconsolidated materials plus a minimum of 20 feet into the underlying formation.
4. If the well is dry hole, an agreement between the operator and the district office on plug length and placement is necessary **prior to plugging**;
5. The appropriate district office will be notified before well is either plugged or production casing is cemented in;
6. If an ALTERNATE II COMPLETION, production pipe shall be cemented from below any usable water to surface within **120 days** of spud date.
Or pursuant to Appendix "B" - Eastern Kansas surface casing order #133,891-C, which applies to the KCC District 3 area, alternate II cementing must be completed within 30 days of the spud date or the well shall be plugged. **In all cases, NOTIFY district office** prior to any cementing.

I hereby certify that the statements made herein are true and to the best of my knowledge and belief.

Date: 8-14-06 Signature of Operator or Agent: Lester Scheuneman Title: owner/operator

For KCC Use ONLY
API # 15 - 121-28275-0000
Conductor pipe required None feet
Minimum surface pipe required 20 feet per Alt. **X 2**
Approved by: RH 8-17-06
This authorization expires: 2-17-07
(This authorization void if drilling not started within 6 months of approval date.)
Spud date: _____ Agent: _____

Remember to:

- File Drill Pit Application (form CDP-1) with Intent to Drill;
- File Completion Form ACO-1 within 120 days of spud date;
- File acreage attribution plat according to field proration orders;
- Notify appropriate district office 48 hours prior to workover or re-entry;
- Submit plugging report (CP-4) after plugging is completed;
- Obtain written approval before disposing or injecting salt water.
- If this permit has expired (See: authorized expiration date) please check the box below and return to the address below.

Well Not Drilled - Permit Expired

Signature of Operator or Agent: _____
Date: _____

Mail to: KCC - Conservation Division, 130 S. Market - Room 2078, Wichita, Kansas 67202

RECEIVED
AUG 17 2006
KCC WICHITA

IN ALL CASES PLOT THE INTENDED WELL ON THE PLAT BELOW

Plat of acreage attributable to a well in a prorated or spaced field

If the intended well is in a prorated or spaced field, please fully complete this side of the form. If the intended well is in a prorated or spaced field complete the plat below showing that the well will be properly located in relationship to other wells producing from the common source of supply. Please show all the wells and within 1 mile of the boundaries of the proposed acreage attribution unit for gas wells and within 1/2 mile of the boundaries of the proposed acreage attribution unit for oil wells.

API No. 15 - 121-28275-0000
 Operator: Lester Scheuneman
 Lease: Boyscout
 Well Number: A-5
 Field: Rantaul
 Number of Acres attributable to well: 200
 QTR / QTR / QTR of acreage: _____

Location of Well: County: Miami
2142 feet from N / S Line of Section
4023 feet from E / W Line of Section
 Sec. 14 Twp. 17 S. R. 21 East West

Is Section: Regular or Irregular



If Section is Irregular, locate well from nearest corner boundary.

Section corner used: NE NW SE SW

PLAT

(Show location of the well and shade attributable acreage for prorated or spaced wells.)

(Show footage to the nearest lease or unit boundary line.)

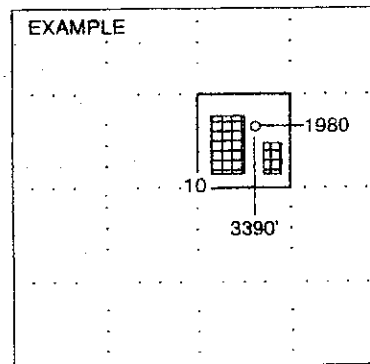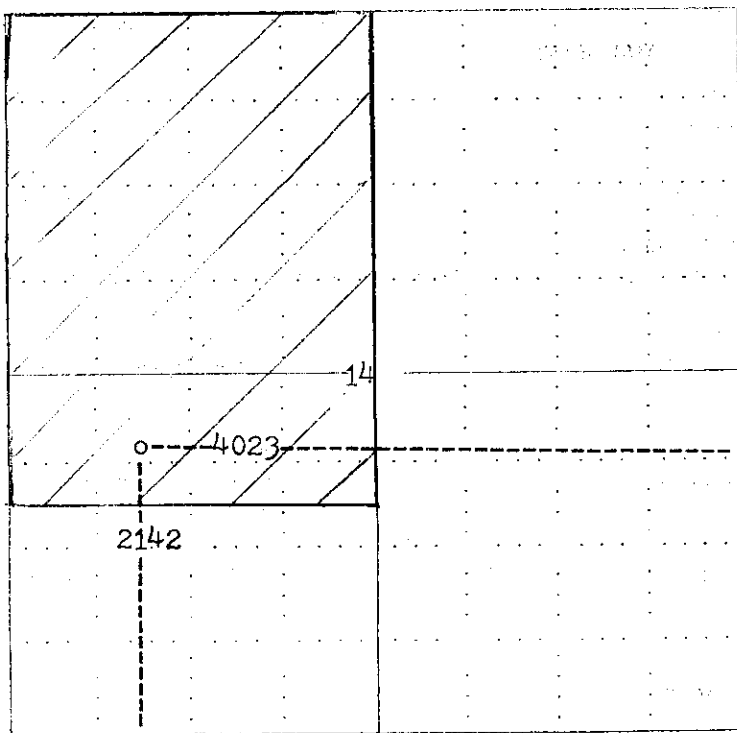

NOTE: In all cases locate the spot of the proposed drilling location.
Miami Co.

In plotting the proposed location of the well, you must show:

1. The manner in which you are using the depicted plat by identifying section lines, i.e. 1 section, 1 section with 8 surrounding sections, 4 sections, etc.
2. The distance of the proposed drilling location from the section's south / north and east / west.
3. The distance to the nearest lease or unit boundary line.
4. If proposed location is located within a prorated or spaced field a certificate of acreage attribution plat must be attached: (CO-7 for oil wells; CG-8 for gas wells).

KANSAS CORPORATION COMMISSION
OIL & GAS CONSERVATION DIVISION

Form CDP-1
April 2004
Form must be Typed

APPLICATION FOR SURFACE PIT

Submit in Duplicate

| | | |
|--|--|--|
| Operator Name: Lester Scheuneman | | License Number: 6168 |
| Operator Address: 27800 Pleasant Valley Rd. Wellsville, Ks. 66092 | | |
| Contact Person: Lester Scheuneman | | Phone Number: (785) 883-4621 |
| Lease Name & Well No.: Boy Scout A-5 | | Pit Location (Q000): |
| Type of Pit: | Pit is: | NE NW SW SE |
| <input type="checkbox"/> Emergency Pit <input type="checkbox"/> Burn Pit | <input checked="" type="checkbox"/> Proposed <input type="checkbox"/> Existing | Sec. 14 Twp. 17 R. 21 <input checked="" type="checkbox"/> East <input type="checkbox"/> West |
| <input type="checkbox"/> Settling Pit <input checked="" type="checkbox"/> Drilling Pit | If Existing, date constructed: | 2142 Feet from <input type="checkbox"/> North / <input checked="" type="checkbox"/> South Line of Section |
| <input type="checkbox"/> Workover Pit <input type="checkbox"/> Haul-Off Pit <small>(If WP Supply API No. or Year Drilled)</small> | Pit capacity: | 4023 Feet from <input checked="" type="checkbox"/> East / <input type="checkbox"/> West Line of Section |
| | 80 (bbls) | Miami County |
| Is the pit located in a Sensitive Ground Water Area? <input type="checkbox"/> Yes <input checked="" type="checkbox"/> No | | Chloride concentration: _____ mg/l <small>(For Emergency Pits and Settling Pits only)</small> |
| Is the bottom below ground level? <input checked="" type="checkbox"/> Yes <input type="checkbox"/> No | Artificial Liner? <input type="checkbox"/> Yes <input checked="" type="checkbox"/> No | How is the pit lined if a plastic liner is not used? clay |
| Pit dimensions (all but working pits): 20 Length (feet) 8 Width (feet) N/A: Steel Pits | | |
| Depth from ground level to deepest point: 4 (feet) | | |
| If the pit is lined give a brief description of the liner material, thickness and installation procedure. | | Describe procedures for periodic maintenance and determining liner integrity, including any special monitoring. |
| Distance to nearest water well within one-mile of pit NA feet Depth of water well _____ feet | | Depth to shallowest fresh water _____ feet. Source of information: _____ measured _____ well owner _____ electric log _____ KDWR |
| Emergency, Settling and Burn Pits ONLY: | | Drilling, Workover and Haul-Off Pits ONLY: |
| Producing Formation: _____ | | Type of material utilized in drilling/workover: Fresh water mud. |
| Number of producing wells on lease: _____ | | Number of working pits to be utilized: 1 |
| Barrels of fluid produced daily: _____ | | Abandonment procedure: Evaporate & backfill |
| Does the slope from the tank battery allow all spilled fluids to flow into the pit? <input type="checkbox"/> Yes <input type="checkbox"/> No | | Drill pits must be closed within 365 days of spud date |
| I hereby certify that the above statements are true and correct to the best of my knowledge and belief. | | |
| 8-14-06 Date | Lester Scheuneman Signature of Applicant or Agent | |

15-121-28275-0000

| KCC OFFICE USE ONLY | | | |
|------------------------|----------------------|----------------------|---|
| Date Received: 8/17/06 | Permit Number: _____ | Permit Date: 8/17/06 | Lease Inspection: <input type="checkbox"/> Yes <input checked="" type="checkbox"/> No |

Mail to: KCC - Conservation Division, 130 S. Market - Room 2078, Wichita, Kansas 67202

RECEIVED
AUG 17 2006
KCC WICHITA