

CARD MUST BE TYPED

State of Kansas

CARD MUST BE SIGNED

NOTICE OF INTENTION TO DRILL

(see rules on reverse side)

Extension #

Starting Date 11 - 16 - 1987 month day year

API Number 15-121-26,875-00-00 NY2-542-NY2 N/W N/W 1 3630 Sec. 4 Twp. 19 S, Rg. 24

OPERATOR: License # 8087

2640 Ft. from South Line of Section 2640 Ft. from East Line of Section

Name Korinc Capt. Fed. Bldg. Suite 401. 95th

Address City/State/Zip Nall Overland Park, Kan 66207

Contact Person Paul Jackson

Phone 913 795 2586

CONTRACTOR: License # 6157

Name J & J Oil Company

City/State Box 298 Mound City Kansas

Well Drilled For: Oil SWD Infield Mud Rotary Gas Inj Pool Ext Air Rotary OWWO Expl Wildcat Cable

Well Class: Infield Mud Rotary Pool Ext Air Rotary Wildcat Cable

Type Equipment: Mud Rotary Air Rotary Cable

If OWWO: old well info as follows: Operator Well Name Comp Date Old Total Depth

(Note: Locate well on Section Plat on reverse side) Nearest lease or unit boundary line 1320 feet County Miami Lease Name Korinc Well # p PP-6 Ground surface elevation N/A feet MSL Domestic well within 330 feet: yes no Municipal well within one mile: yes no Depth to bottom of fresh water 60 Depth to bottom of usable water 150-200 Surface pipe by Alternate: 1 2 X Surface pipe planned to be set 20' Conductor pipe required No Projected Total Depth 200' Formation Peru

I certify that well will comply with K.S.A. 55-101, et seq., plus eventually plugging hole to KCC specifications. Date 11/7/1987 Signature of Operator or Agent Paul Jackson Title Contractor

For KCC Use: Conductor Pipe Required feet; Minimum Surface Pipe Required 20 feet per Alt. This Authorization Expires 8-12-88 11-12-88 Approved By P.H. 11-12-87

EFFECTIVE DATE: 11-17-87

Peru 4-28-88


2

Must be filed with the K.C.C. five (5) days prior to commencing well
This card void if drilling not started within six (6) months of date received by K.C.C.

Important procedures to follow:

1. Notify District office before setting surface casing.
2. Set surface casing by circulating cement to the top.
3. File completion forms ACO-1 with K.C.C. within 90 days of well completion, following instructions on ACO-1, side 1, and including copies of wireline logs.
4. Notify District office 48 hours prior to old well workover or re-entry.
5. Prior to filing Intent, prepare a proposed plugging plan in case well is D & A, then obtain approval of plan when calling district office prior to setting surface pipe.
6. Submit plugging report (CP-4) to K.C.C. after plugging is completed.
7. Obtain an approved injection docket number before disposing of salt water.
8. Notify K.C.C. within 10 days when injection commences or terminates.
9. If an alternate 2 completion, cement in the production pipe from below any usable water to surface within 120 days of spud date.

A Regular Section of Land 1 Mile = 5,280 Ft.

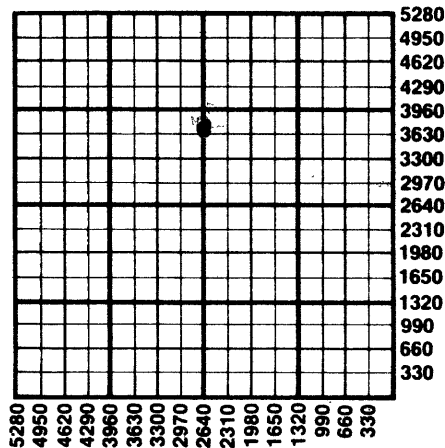

NOV 2 1967
CONSERVATION DIVISION
Wichita, Kansas

State Corporation Commission of Kansas
Conservation Division
200 Colorado Derby Building
Wichita, Kansas 67202
(316) 263-3238