

CARD MUST BE TYPED

State of Kansas

CARD MUST BE SIGNED

NOTICE OF INTENTION TO DRILL

(see rules on reverse side)

✓ 10

Expected Spud Date..... 02/08/88.....
month day year

API Number 15— 003-22,880-00-00

OPERATOR: License #..... 6004.....

Sec. 16 Twp. 21 S, Rg. 20 East West

Name CALDWELL ENTERPRISES.....

3700 Ft. from South Line of Section

Address BOX 42.....

2370 Ft. from East Line of Section

City/State/Zip GARNETT..... 66032

(Note: Locate well on Section Plat on reverse side)

Contact Person..... GLENN CALDWELL.....

Nearest lease or unit boundary line 260 feet

Phone..... (913) 448-3578.....

County..... Anderson

CONTRACTOR: License #5820.....

Lease Name..... Rugsley Well #..... 1-28

Name Kent Drilling Co.....

Ground surface elevation feet MSL

City/State..... Garnett..... Kansas..... 66032..

Domestic well within 330 feet: yes no

Well Drilled For: Well Class: Type Equipment:

Municipal well within one mile: yes no

Oil Storage Infield Mud Rotary

Depth to bottom of fresh water.....

Gas Inj Pool Ext. Air Rotary

Depth to bottom of usable water 125

OWWO Expl Wildcat Cable

Surface pipe by Alternate: 1 2

If OWWO: old well info as follows:

Surface pipe planned to be set 20

Operator

Conductor pipe required

Well Name

Projected Total Depth 900 feet

Comp Date..... Old Total Depth.....

Formation..... Squirrel

I certify that well will comply with K.S.A. 55-101, et seq., plus eventually plugging hole to KCC specifications.

Date 02/04/88 Signature of Operator or Agent *Greg Engleman* Title As Agent

For KCC Use:

Conductor Pipe Required feet; Minimum Surface Pipe Required 20 feet per Alt. X(2)

This Authorization Expires 8-4-88 Approved By *Per 2-4-88*


EFFECTIVE DATE: 2-9-88

Must be filed with the K.C.C. five (5) days prior to commencing well
This card void if drilling not started within six (6) months of date received by K.C.C.

Important procedures to follow:

1. Notify District office before setting surface casing.
2. Set surface casing by circulating cement to the top.
3. File completion forms ACO-1 with K.C.C. within 120 days of well spud date, following instructions on ACO-1, side 1, and including copies of wireline logs.
4. Notify District office 48 hours prior to old well workover or re-entry.
5. Prior to filing Intent, prepare a proposed plugging plan in case well is D & A, then obtain approval of plan when calling district office prior to setting surface pipe.
6. Submit plugging report (CP-4) to K.C.C. after plugging is completed.
7. Obtain an approved injection docket number before disposing of salt water.
8. Notify K.C.C. within 10 days when injection commences or terminates.
9. If an alternate 2 completion, cement in the production pipe from below any usable water to surface within 120 days of spud date.

A Regular Section of Land 1 Mile = 5,280 Ft.

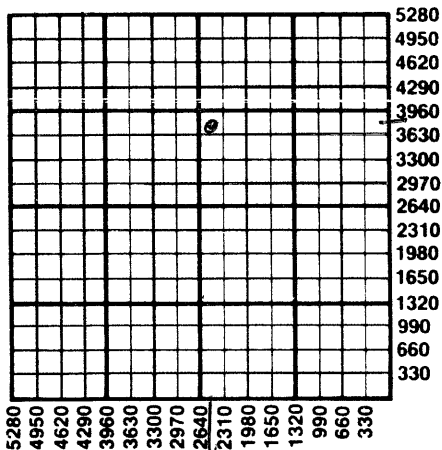

FEB 4 1988

CONSERVATION DIVISION
Wichita, Kansas

State Corporation Commission of Kansas
Conservation Division
200 Colorado Derby Building
Wichita, Kansas 67202-1212
(316) 263-3238

02-04-88