

CARD MUST BE TYPED

State of Kansas

CARD MUST BE SIGNED

NOTICE OF INTENTION TO DRILL

(see rules on reverse side)

Starting Date 5 14 86
 month day year 11:35

OPERATOR: License # 6004
 Name Caldwell Enterprises Inc.
 Address Box 42
 City/State/Zip Garnett, Kansas 66032
 Contact Person Glen Caldwell
 Phone 913-448-3578

CONTRACTOR: License # 5820
 Name [REDACTED] Kent Delg. Co.
 City/State Garnett, Kansas 66032

Well Drilled For:	Well Class:	Type Equipment:
<input checked="" type="checkbox"/> Oil <input type="checkbox"/> SWD <input type="checkbox"/> Infield <input checked="" type="checkbox"/> Mud Rotary		
<input type="checkbox"/> Gas <input type="checkbox"/> Inj <input checked="" type="checkbox"/> Pool Ext. <input type="checkbox"/> Air Rotary		
<input type="checkbox"/> OWWO <input type="checkbox"/> Expl <input type="checkbox"/> Wildcat <input type="checkbox"/> Cable		

If OWWO: old well info as follows:

Operator
 Well Name
 Comp Date Old Total Depth

I certify that well will comply with K.S.A. 55-101, et seq., plus eventually plugging hole to KCC specifications.

Date 5-12-86 Signature of Operator or Agent Title as agent

For KCC Use:

Conductor Pipe Required feet; Minimum Surface Pipe Required feet per Alk ②
 This Authorization Expires 11-12-86 Approved By 5-12-86

API Number 15— 003-22,740-00-00
 app. SE NW NW Sec. 16 Twp. 21 S, Rg. 20
 4160
 4160
 Ft. from South Line of Section
 Ft. from East Line of Section

(Note: Locate well on Section Plat on reverse side)

Nearest lease or unit boundary line 200 feet
 County Anderson
 Lease Name Kirk Well # 37
 Ground surface elevation na feet MSL
 Domestic well within 330 feet: ☐ yes ☒ no
 Municipal well within one mile: ☐ yes ☒ no
 Depth to bottom of fresh water 30
 Depth to bottom of usable water 125
 Surface pipe by Alternate: 1 2 ☒
 Surface pipe planned to be set 20
 Conductor pipe required
 Projected Total Depth 870 feet
 Formation Squirrel


RCH/10/86

Must be filed with the K.C.C. five (5) days prior to commencing well
This card void if drilling not started within six (6) months of date received by K.C.C.

Important procedures to follow:

1. Notify District office before setting surface casing.
2. Set surface casing by circulating cement to the top.
3. File completion forms ACO-1 with K.C.C. within 90 days of well completion, following instructions on ACO-1, side 1, and including copies of wireline logs.
4. Notify District office 48 hours prior to old well workover or re-entry.
5. Prior to filing Intent, prepare a proposed plugging plan in case well is D & A, then obtain approval of plan when calling district office prior to setting surface pipe.
6. Submit plugging report (CP-4) to K.C.C. after plugging is completed.
7. Obtain an approved injection docket number before disposing of salt water.
8. Notify K.C.C. within 10 days when injection commences or terminates.
9. If an alternate 2 completion, cement in the production pipe from below any usable water to surface within 120 days of spud date.

**A Regular Section of Land
1 Mile = 5,280 Ft.**

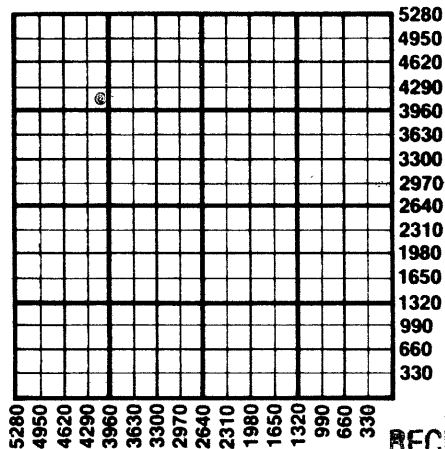

RECEIVED
STATE CORPORATION COMMISSION

MAY 12 1986
05-12-86
CONSERVATION DIVISION
Wichita Kansas

State Corporation Commission of Kansas
Conservation Division
200 Colorado Derby Building
Wichita, Kansas 67202
(316) 263-3238