

CARD MUST BE TYPED

State of Kansas

CARD MUST BE SIGNED

NOTICE OF INTENTION TO DRILL

(see rules on reverse side)

✓ 10

Expected Spud Date..... 01/30/88
month day year

API Number 15-003-22,879-00-00 xx East

OPERATOR: License #..... 6004
Name..... CALDWELL ENTERPRISES

SW SE NE 16 21 20
2970 Sec..... Twp..... S, Rg..... West
1280

Address..... BOX 42
City/State/Zip..... GARNETT 66032

..... Ft. from South Line of Section
..... Ft. from East Line of Section

(Note: Locate well on Section Plat on reverse side)

Contact Person..... GLENN CALDWELL
Phone..... (913) 448-3578

Nearest lease or unit boundary line..... 330 feet
County..... Anderson

CONTRACTOR: License #..... 5820
Name..... Kent Drilling

Lease Name..... Pugsley Well #..... F-25

City/State..... Garnett, Kansas 66032

Ground surface elevation..... feet MSL

Well Drilled For: Well Class: Type Equipment:
xx Oil ___ Storage xx Infield xx Mud Rotary
___ Gas ___ Inj ___ Pool Ext. ___ Air Rotary
___ OWWO ___ Expl ___ Wildcat ___ Cable

Domestic well within 330 feet: ___yes xx no
Municipal well within one mile: ___yes ___no

If OWWO: old well info as follows:

Depth to bottom of fresh water.....
Depth to bottom of usable water..... 125 feet xx

Operator.....
Well Name.....
Comp Date..... Old Total Depth.....

Surface pipe by Alternate: 20 1 2
Surface pipe planned to be set.....
Conductor pipe required.....

I certify that well will comply with K.S.A. 55-101, et seq., plus eventually plugging hole to KCC specifications.
Date 01/28/88 Signature of Operator or Agent [Signature] Title As Agent

For KCC Use:
Conductor Pipe Required..... feet; Minimum Surface Pipe Required..... 20 feet per Alt. X (2)
This Authorization Expires 7-28-88 Approved By [Signature] feet 1-28-88


EFFECTIVE DATE: 2-2-88

Must be filed with the K.C.C. five (5) days prior to commencing well
This card void if drilling not started within six (6) months of date received by K.C.C.

Important procedures to follow:

1. Notify District office before setting surface casing.
2. Set surface casing by circulating cement to the top.
3. File completion forms ACO-1 with K.C.C. within 120 days of well spud date, following instructions on ACO-1, side 1, and including copies of wireline logs.
4. Notify District office 48 hours prior to old well workover or re-entry.
5. Prior to filing Intent, prepare a proposed plugging plan in case well is D & A, then obtain approval of plan when calling district office prior to setting surface pipe.
6. Submit plugging report (CP-4) to K.C.C. after plugging is completed.
7. Obtain an approved injection docket number before disposing of salt water.
8. Notify K.C.C. within 10 days when injection commences or terminates.
9. If an alternate 2 completion, cement in the production pipe from below any usable water to surface within 120 days of spud date.

A Regular Section of Land 1 Mile = 5,280 Ft.

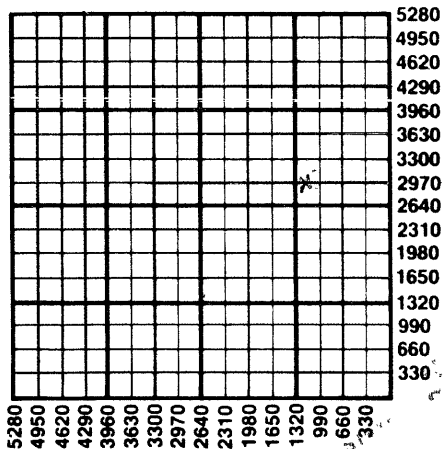

01 JAN 28 1988
COUNCIL ON WATER DIVISION
Wichita, Kansas

State Corporation Commission of Kansas
Conservation Division
200 Colorado Derby Building
Wichita, Kansas 67202-1212
(316) 263-3238