

CARD MUST BE TYPED

State of Kansas

CARD MUST BE SIGNED

NOTICE OF INTENTION TO DRILL

(see rules on reverse side)

Starting Date May 16 1986
month day year *10:54*

API Number 15— *003-22,741-00-00*

OPERATOR: License # 6004
Name ... *Caldwell Enterprises Inc.*
Address ... *Box 42*
City/State/Zip *Garnett, Kansas 66032*
Contact Person... *Glen Caldwell*
Phone..... *913 448 3578*

East
NW.NE..NW..... Sec18.... Twp.21... S, Rg....20. ___ West
.....4980..... Ft. from South Line of Section
.....3430..... Ft. from East Line of Section

(Note: Locate well on Section Plat on reverse side)

CONTRACTOR: License # 5820
Name ... *Kent Drilling Co.*
City/State *Garnett, Kansas 66032*

Nearest lease or unit boundary line 300 feet
County.... *Anderson*

Well Drilled For: Well Class: Type Equipment:
 Oil ___ SWD ___ Infield Mud Rotary
___ Gas ___ Inj Pool Ext. ___ Air Rotary
___ OWWO ___ Expl ___ Wildcat ___ Cable

Lease Name..... *Sobba*..... Well # .. 5
Ground surface elevation *na* feet MSL

If OWWO: old well info as follows:
Operator
Well Name
Comp Date Old Total Depth.....

Domestic well within 330 feet: ___ yes no
Municipal well within one mile: ___ yes no
Depth to bottom of fresh water..... 20
Depth to bottom of usable water 125
Surface pipe by Alternate: 1 ___ 2
Surface pipe planned to be set 20
Conductor pipe required
Projected Total Depth 870 feet
Formation *Squirrel*

I certify that well will comply with K.S.A. 55-101, et seq., plus eventually plugging hole to KCC specifications.

Date *5/16/86* Signature of Operator or Agent *Clarice Duncan* Title as agent

For KCC Use:

Conductor Pipe Required feet: Minimum Surface Pipe Required *20* feet per Alt. *40*
This Authorization Expires *11-16-86* Approved By *5-16-86*


Ret/KCS

Must be filed with the K.C.C. five (5) days prior to commencing well
 This card void if drilling not started within six (6) months of date received by K.C.C.

Important procedures to follow:

1. Notify District office before setting surface casing.
2. Set surface casing by circulating cement to the top.
3. File completion forms ACO-1 with K.C.C. within 90 days of well completion, following instructions on ACO-1, side 1, and including copies of wireline logs.
4. Notify District office 48 hours prior to old well workover or re-entry.
5. Prior to filing Intent, prepare a proposed plugging plan in case well is D & A, then obtain approval of plan when calling district office prior to setting surface pipe.
6. Submit plugging report (CP-4) to K. C. C. after plugging is completed.
7. Obtain an approved injection docket number before disposing of salt water.
8. Notify K.C.C. within 10 days when injection commences or terminates.

A Regular Section of Land
1 Mile = 5,280 Ft.

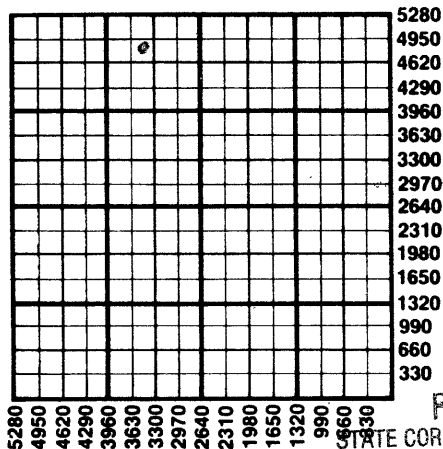

RECEIVED

STATE CORPORATION COMMISSION

MAY 16 1986
 05-16-86
 CONSERVATION DIVISION
 Wichita, Kansas

alternate 2 completion, cement in the production pipe from below any usable water to surface within 120 days of spud date.

State Corporation Commission of Kansas
 Conservation Division
 200 Colorado Derby Building
 Wichita, Kansas 67202
 (316) 263-3238