

CARD MUST BE TYPED

State of Kansas

CARD MUST BE SIGNED

NOTICE OF INTENTION TO DRILL

(see rules on reverse side)

Starting Date May 16 1986 month day year 10.54

API Number 15-003-22, 742-00-00

OPERATOR: License # 6004 app. NW NE NW Name Caldwell Enterprises, Inc. Address Box 42 City/State/Zip Garnett, Kansas 66032 Contact Person Glen Caldwell Phone 913 448 3578

Sec 18 Twp. 21 S, Rg. 20 4980 Ft. from South Line of Section 3660 Ft. from East Line of Section

(Note: Locate well on Section Plat on reverse side)

CONTRACTOR: License # 5820 Name Kent Drilling Co. City/State Garnett, KS 66032

Nearest lease or unit boundary line 300 feet County Anderson

Well Drilled For: Well Class: Type Equipment: Oil SWD Infield Mud Rotary Gas Inj Pool Ext Air Rotary OWWO Expl Wildcat Cable

Lease Name Sobba Well # 6 Ground surface elevation na feet MSL Domestic well within 330 feet: yes no Municipal well within one mile: yes no Depth to bottom of fresh water 20 Depth to bottom of usable water 125 Surface pipe by Alternate: 1 2 Surface pipe planned to be set 20 Conductor pipe required Projected Total Depth 870 feet Formation Squirrel

If OWWO: old well info as follows:

Operator Well Name Comp Date Old Total Depth

I certify that well will comply with K.S.A. 55-101, et seq., plus eventually plugging hole to KCC specifications.

Date 5/16/86 Signature of Operator or Agent Title as agent

For KCC Use:

Conductor Pipe Required feet; Minimum Surface Pipe Required 2.0 feet per Approved By 5-16-86

This Authorization Expires 11-16-86


Handwritten signatures and initials including 'RCH/KCONE' and 'RGO'.

Must be filed with the K.C.C. five (5) days prior to commencing well  
 This card void if drilling not started within six (6) months of date received by K.C.C.

**Important procedures to follow:**

1. Notify District office before setting surface casing.
2. Set surface casing by circulating cement to the top.
3. File completion forms ACO-1 with K.C.C. within 90 days of well completion, following instructions on ACO-1, side 1, and including copies of wireline logs.
4. Notify District office 48 hours prior to old well workover or re-entry.
5. Prior to filing Intent, prepare a proposed plugging plan in case well is D & A, then obtain approval of plan when calling district office prior to setting surface pipe.
6. Submit plugging report (CP-4) to K.C.C. after plugging is completed.
7. Obtain an approved injection docket number before disposing of salt water.
8. Notify K.C.C. within 10 days when injection commences or terminates.

**A Regular Section of Land  
 1 Mile = 5,280 Ft.**

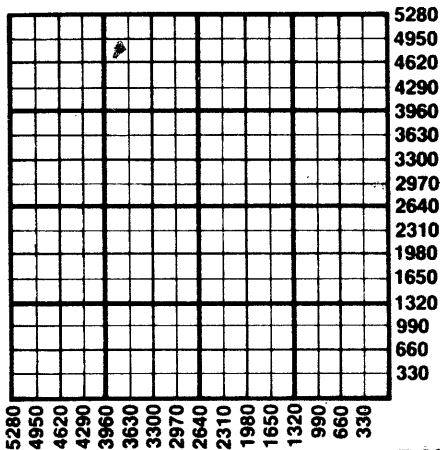

RECEIVED

STATE CORPORATION COMMISSION

MAY 16 1986  
 05-16-86  
 CONSERVATION DIVISION  
 Wichita, Kansas

9. If an alternate 2 completion, cement in the production pipe from  
 any usable water to surface within 120 days of spud date.

State Corporation Commission of Kansas  
 Conservation Division  
 200 Colorado Derby Building  
 Wichita, Kansas 67202  
 (316) 263-3238