

CARD MUST BE TYPED

State of Kansas

CARD MUST BE SIGNED

NOTICE OF INTENTION TO DRILL

(see rules on reverse side)

Starting Date 5 28 86
month day year 11:40

API Number 15— 003-22,745-00-00

OPERATOR: License # 6004
Name Caldwell Enterprises, Inc.
Address Box 42
City/State/Zip Garnett, Kansas 66032
Contact Person Glen Caldwell
Phone 913-448-3578

..... X East
app. NE NW NW Sec. 18 Twp. 21 S, Rg. 20 West
..... 4640 Ft. from South Line of Section
..... 4400 Ft. from East Line of Section

(Note: Locate well on Section Plat on reverse side)

CONTRACTOR: License # 5820
Name Kent Drilling Co.
City/State Garnett, Kansas 66032

Nearest lease or unit boundary line 640 feet
County Anderson
Lease Name Sobba Well # 8
Ground surface elevation n/a feet MSL

Well Drilled For: Well Class: Type Equipment:
 Oil SWD Infield Mud Rotary
 Gas Inj Pool Ext. Air Rotary
 OWWO Expl Wildcat Cable

Domestic well within 330 feet: yes no
Municipal well within one mile: yes no
Surface pipe by Alternate: 1 2
Depth to bottom of fresh water 20
Depth to bottom of usable water 125
Surface pipe planned to be set 20
Projected Total Depth 870 feet
Formation Squirrel

If OWWO: old well info as follows:
Operator
Well Name
Comp Date Old Total Depth

I certify that well will comply with K.S.A. 55-101, et seq., plus eventually plugging hole to KCC specifications.

~~Alternate cementing will be done immediately~~
Date 5-28-86 Signature of Operator or Agent *Donald D. Emore* Title as agent

For KCC Use:
Conductor Pipe Required feet; Minimum Surface Pipe Required 20 feet per Alt. *400*
This Authorization Expires 11-28-86 Approved By 5-28-86 *RE*


feet/1000

Must be filed with the K.C.C. five (5) days prior to commencing well
 This card void if drilling not started within six (6) months of date received by K.C.C.

Important procedures to follow:

1. Notify District office before setting surface casing.
2. Set surface casing by circulating cement to the top.
3. File completion forms ACO-1 with K.C.C. within 90 days of well completion, following instructions on ACO-1, side 1, and including copies of wireline logs.
4. Notify District office 48 hours prior to old well workover or re-entry.
5. Prior to filing Intent, prepare a proposed plugging plan in case well is D & A, then obtain approval of plan when calling district office prior to setting surface pipe.
6. Submit plugging report (CP-4) to K. C. C. after plugging is completed.
7. Obtain an approved injection docket number before disposing of salt water.
8. Notify K.C.C. within 10 days when injection commences or terminates.
9. If an alternate 2 completion, cement in the production pipe from below any usable water to surface within 120 days of spud date.

**A Regular Section of Land
 1 Mile = 5,280 Ft.**

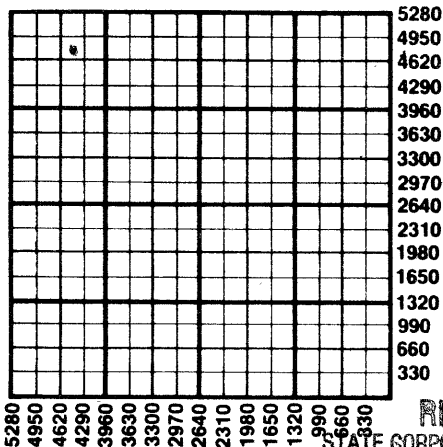

RECEIVED
 STATE CORPORATION COMMISSION

MAY 28 1980
 05-28-86
 CONSERVATION DIVISION
 Wichita, Kansas

State Corporation Commission of Kansas
 Conservation Division
 200 Colorado Derby Building
 Wichita, Kansas 67202
 (316) 263-3238