

CARD MUST BE TYPED

State of Kansas  
**NOTICE OF INTENTION TO DRILL**  
(see rules on reverse side)

CARD MUST BE SIGNED

Starting Date: 5/30/85  
month day year

API Number 15- 207-25,289-0000

OPERATOR: License # 7018

NE NE NE Sec 3 Twp 24 S, Rge 16  East  
(location)  West

Name Laymon Oil Company

Address Rt. 1

City/State/Zip Neosho Falls, KS 66758

Contact Person Kenneth Laymon

Phone 316-963-2495

4840 Ft North from Southeast Corner of Section  
395 Ft West from Southeast Corner of Section  
(Note: Locate well on Section Plat on reverse side)

CONTRACTOR: License # 5661

Name Kelly Down Drilling Company

City/State Neosho Falls, KS 66758

Nearest lease or unit boundary line 395 feet.

County Woodson

Lease Name Roberts "B." Well# .6

Domestic well within 330 feet:  yes  no

Municipal well within one mile:  yes  no

Well Drilled For: Well Class: Type Equipment:

Oil  Swd  Infield  Mud Rotary  
 Gas  Inj  Pool Ext.  Air Rotary  
 OWWO  Expl  Wildcat  Cable

Depth to Bottom of fresh water none feet

Lowest usable water formation .....

Depth to Bottom of usable water 150 feet

Surface pipe by Alternate: 1  2

Surface pipe to be set 40 feet

Conductor pipe if any required .....

Ground surface elevation 1080 feet MSL

This Authorization Expires 11-29-85

Approved By 5-29-85 [Signature]

If OWWO: old well info as follows:

Operator .....

Well Name .....

Comp Date ..... Old Total Depth .....

Projected Total Depth 1100 feet

Projected Formation at TD Squirrel

Expected Producing Formations .....

I certify that we will comply with K.S.A. 55-101, et seq., plus eventually plugging hole to K.C.C. specifications.

Date 5/29/85 Signature of Operator or Agent Susan Arnold

Title As Agent

WICHITA, KANSAS  
CONSERVATION DIVISION

Must be filed with the K.C.C. five (5) days prior to commencing well  
This card void if drilling not started within six (6) months of date received by K.C.C.

MAY 29 1985


5-29-85

**Important procedures to follow:**

1. Notify District office before setting surface casing.
2. Set surface casing by circulating cement to the top.
3. File completion forms ACO-1 with K.C.C. within 90 days of well completion, following instructions on ACO-1, side 1, and including copies of wireline logs.
4. Notify District office 48 hours prior to old well workover or re-entry.
5. Prior to plugging, prepare a plugging plan, then obtain agreement from the appropriate district office for an approved plugging plan.
6. Submit plugging report (CP-4) to K.C.C. after plugging is completed.
7. Obtain an approved injection docket number before disposing of salt water.
8. Notify K.C.C. within 10 days when injection commences or terminates.
9. If an alternate 2 completion, cement in the production pipe from below any usable water to surface within 120 days of spud date.

STATE CORPORATION COMMISSION

**A Regular Section of Land**  
**1 Mile = 5,280 Ft.**

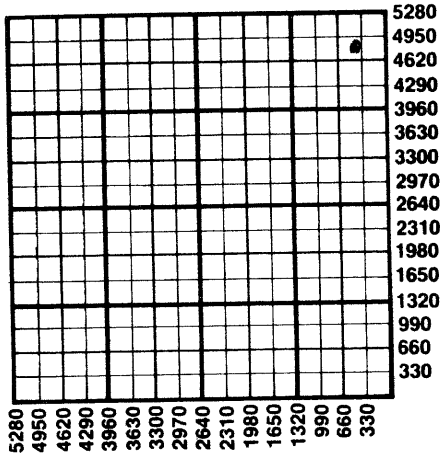

State Corporation Commission of Kansas  
Conservation Division  
200 Colorado Derby Building  
Wichita, Kansas 67202  
(316) 263-3238