

CARD MUST BE TYPED

State of Kansas

CARD MUST BE SIGNED

NOTICE OF INTENTION TO DRILL

(see rules on reverse side)

Expected Spud Date..... 3/25/87
month day year

API Number 15— 207-25,504-00-00

OPERATOR: License # 7559
Name J.M. Sturdivan
Address Rt. 1
City/State/Zip LeRoy, Kansas 66857
Contact Person J.M. Sturdivan
Phone 316-964-2278

East
 West
NE~~1~~ NE~~1~~ NE~~1~~ Sec 4..... Twp 24 S, Rg. 16
5115 Ft. from South Line of Section
555 Ft. from East Line of Section

(Note: Locate well on Section Plat on reverse side)

CONTRACTOR: License # 5661
Name Kelly Down Drilling Co., Inc.
City/State Neosho Falls, Kansas 66758

Nearest lease or unit boundary line 165 feet
County Woodson

Lease Name Sturdivan Well # 9
Ground surface elevation 1077 feet MSL

Well Drilled For: Well Class: Type Equipment:
 Oil Storage Infield Mud Rotary
 Gas Inj Pool Ext. Air Rotary
 OWWO Expl Wildcat Cable

Domestic well within 330 feet: yes no
Municipal well within one mile: yes no

Depth to bottom of fresh water none
Depth to bottom of usable water 150

If OWWO: old well info as follows:

Surface pipe by Alternate: 1 2
Surface pipe planned to be set 40!

Operator
Well Name
Comp Date Old Total Depth

Conductor pipe required
Projected Total Depth 1120 feet

I certify that well will comply with K.S.A. 55-101, et seq., plus eventually plugging hole to KCC specifications.

Date Signature of Operator or Agent J.M. Sturdivan Title Operator

For KCC Use:

Conductor Pipe Required feet; Minimum Surface Pipe Required 40 feet per Alt. 40

This Authorization Expires 9-18-87 Approved By 3-18-87


J.M. Sturdivan
Operator

Must be filed with the K.C.C. five (5) days prior to commencing well
 This card void if drilling not started within six (6) months of date received by K.C.C.

Important procedures to follow:

1. Notify District office before setting surface casing.
2. Set surface casing by circulating cement to the top.
3. File completion forms ACO-1 with K.C.C. within 120 days of well spud date, following instructions on ACO-1, side 1, and including copies of wireline logs.
4. Notify District office 48 hours prior to old well workover or re-entry.
5. Prior to filing Intent, prepare a proposed plugging plan in case well is D & A, then obtain approval of plan when calling district office prior to setting surface pipe.
6. Submit plugging report (CP-4) to K.C.C. after plugging is completed.
7. Obtain an approved injection docket number before disposing of salt water.
8. Notify K.C.C. within 10 days when injection commences or terminates.
9. If an alternate 2 completion, cement in the production pipe from below any usable water to surface within 120 days of spud date.

**A Regular Section of Land
 1 Mile = 5,280 Ft.**

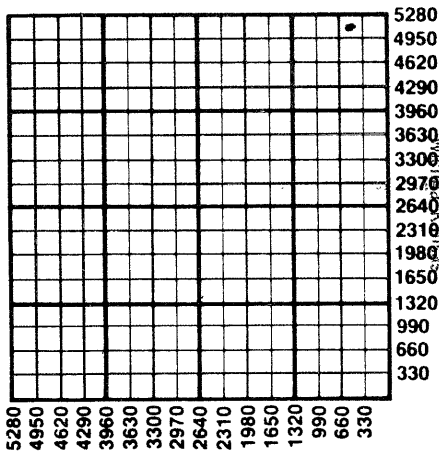

CONSERVATION DIVISION

MAR 18 1987

STATE CORPORATION COMMISSION

3-18-87

State Corporation Commission of Kansas
 Conservation Division
 200 Colorado Derby Building
 Wichita, Kansas 67202-1212
 (316) 263-3238