

CARD MUST BE TYPED

State of Kansas NOTICE OF INTENTION TO DRILL

CARD MUST BE SIGNED

(see rules on reverse side)

Starting Date: 10 10 84
month day year

API Number 15- 207-25,060-00-00

OPERATOR: License # 7018
Name Laymon Oil Company
Address Rt. 1
City/State/Zip Neosho Falls, Ks. 66758
Contact Person Kenneth Laymon
Phone 316-963-2495

NE1 Sec. 3 Twp 24 S, Rge 16 .. East
(location) West
4780 Ft North from Southeast Corner of Section
1055 Ft West from Southeast Corner of Section
(Note: Locate well on Section Plat on reverse side)

CONTRACTOR: License # 5661
Name Kelly Down Drilling Co., Inc.
City/State Neosho Falls, Ks. 66758

Nearest lease or unit boundary line 1055 feet.
County Woodson
Lease Name Roberts B Well# 8

Well Drilled For: Well Class: Type Equipment:
 Oil Swd Infield Mud Rotary
 Gas Inj Pool Ext. Air Rotary
 OWWO Expl Wildcat Cable

Domestic well within 330 feet: yes no
Municipal well within one mile: yes no

Depth to Bottom of fresh water 150 feet
Lowest usable water formation none
Depth to Bottom of usable water none 150 feet
Surface pipe by Alternate: 1 2
Surface pipe to be set 40 feet
Conductor pipe if any required none feet
Ground surface elevation 1080 feet MSL

If OWWO: old well info as follows:
Operator
Well Name
Comp Date Old Total Depth
Projected Total Depth 1100 feet
Projected Formation at TD
Expected Producing Formations Squirrel

This Authorization Expires 3-26-85
Approved By 9-26-84 *R*


I certify that we will comply with K.S.A. 55-101, et seq., plus eventually plugging hole to K.C.C. specifications.

Date 9/24/84 Signature of Operator or Agent Regina Laymon Title Prtnr
Form C-1 4/84

**Must be filed with the K.C.C. five (5) days prior to commencing well
This card void if drilling not started within six (6) months of date received by K.C.C.**

Important procedures to follow :

**A Regular Section of Land
1 Mile = 5,280 Ft.**

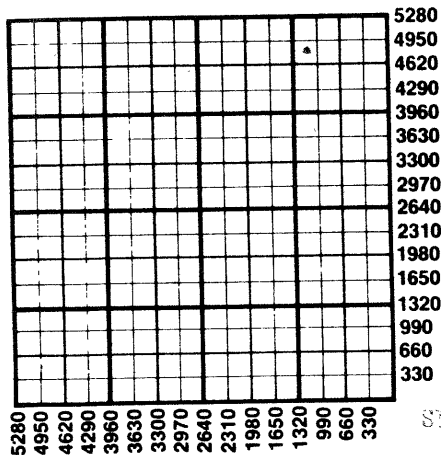

1. Notify District office before setting surface casing.
2. Set surface casing by circulating cement to the top.
3. File completion forms ACO-1 with K.C.C. within 90 days of well completion, following instructions on ACO-1, side 1, and including copies of wireline logs.
4. Notify District office 48 hours prior to old well workover or re-entry.
5. Prior to plugging, prepare a plugging plan, then obtain agreement from the appropriate district office for an approved plugging plan.
6. Submit plugging report (CP-4) to K.C.C. after plugging is completed.
7. Obtain an approved injection docket number before disposing of salt water.
8. Notify K.C.C. within 10 days when injection commences or terminates.
9. If an alternate 2 completion, cement in the production pipe from below any usable water to surface within 120 days of spud date.

RECEIVED

STATE CORPORATION COMMISSION

State Corporation Commission of Kansas

Conservation Division

200 Colorado Derby Building

Wichita, Kansas 67202

(316) 263-3238

9-26-84

SEP 26 1984

CONSERVATION DIVISION

Wichita, Kansas