

KANSAS CORPORATION COMMISSION
OIL & GAS CONSERVATION DIVISION

Form CP-1
September 2003
Form must be Typed
Form must be Signed
All blanks must be Filled

WELL PLUGGING APPLICATION

Please TYPE Form and File ONE Copy

API # 15-067-20159-0000 (Identifier Number of this well). This must be listed for wells drilled since 1967; if no API # was issued.

Indicate original spud or completion date S04-22-72 C05-12-72

Well Operator: BP AMERICA PRODUCTION COMPANY KCC License #: 5952
(Owner/Company Name) (Operator's)

Address: P. O. BOX 3092, WL1 RM 3.201 City: HOUSTON

State: TEXAS Zip Code: 77253-3092 Contact Phone: 281 366-4395

Lease: R.R. WILSON B Well #: 2 Sec. 17 Twp. 28 S R. 38 East West

C E/2 Spot Location/QQQQ County GRANT

2470 Feet from (in exact footage) North / South (from nearest outside section corner) Line of Section (not Lease Line)

1250 Feet from (in exact footage) East / West (from nearest outside section corner) Line of Section (not Lease Line)

Check One: Oil Well Gas Well D&A Cathodic Water Supply Well
 SWD Docket # _____ ENHR Docket # _____ Other _____

Conductor Casing Size: _____ Set at: _____ Cemented with: _____ Sacks

Surface Casing Size: 8 - 5/8" Set at: 665' Cemented with: 385 Sacks

Production Casing Size: 5 - 1/2" Set at: 2878' Cemented with: 560 Sacks

List (ALL) Perforations and Bridgeplug Sets: 2631-2816'

Elevation: 3114' (G.L. K.B.) T.D. 2878' PBDT _____ Anhydrite Depth _____
(Stone Corral Formation)

Condition of Well: Good Poor Casing Leak Junk in Hole

Proposed Method of Plugging (attach a separate page if additional space is needed): SEE ATTACHED PROCEDURES.

Is Well Log attached to this application as required? Yes No Is ACO-1 filed? Yes No

If not explain why? _____

Plugging of this Well will be done in accordance with K.S.A. 55-101 et. seq. and the Rules and Regulations of the State Corporation Commission

List Name of Company Representative authorized to be in charge of plugging operations:

DEANN SMYERS Phone: 281 366-4395

Address: P. O. BOX 3092, WL 1, RM 3.201 City/State HOUSTON, TEXAS 77253-3092

Plugging Contractor HALLIBURTON SERVICES KCC License # 5287
(Company Name) (Contractor's)

Address _____ Phone: _____

Proposed Date and Hour of Plugging (if known?): _____

Payment of the Plugging Fee (K.A.R. 82-3-118) will be guaranteed by Operator or Agent

Date: JULY 26, 2006 Authorized Operator / Agent: _____

(Signature)

Mail to: KCC - Conservation Division, 130 S. Market - Room 2078, Wichita, Kansas 67202

AUG 03 2006
8-3-06
KCC WICHITA

Plugging Application
R.R. Wilson B 2 - Abandonment
Sec 17, T28S, R38W
Grant County, Kansas

The application attached is to abandon the R.R. Wilson B 2. BP Amoco is abandoning this well as it has become uneconomic to operate.

AUG 03 2005
KCC WICHITA

**Plugging Procedure for the R.R. Wilson B 2
Section 17 T28S R38W
Grant County, Kansas**

NOTE – NOTIFY KCC DISTRICT OFFICE AT LEAST FIVE DAYS IN ADVANCE OF WORK.


This procedure was approved via a telephone conversation between Joe Eudey (BP representative) and Steve Durant (KCC) on February 15, 2006.

PROPOSED PROCEDURE:

1. Mix and pump cement to fill 5.5" casing from ground level to bottom perforation. Mix 800 pounds of cottonseed hulls in lead cement to seal off perfs. Pressure casing to 300psi.
2. Have 50 extra sacks of cement on location to pump down the annulus between the 8.625" & 5.5" casing, if needed. Pressure annulus to 300psi.
3. Cut off and cap the casings 5' below ground level.
4. Restore the location.

**AUG 03 2006
KCC WICHITA**


R.R. Wilson B 2
Section 17, T28S, R38W
Council Grove Formation
Panoma Field
Grant County, Kansas

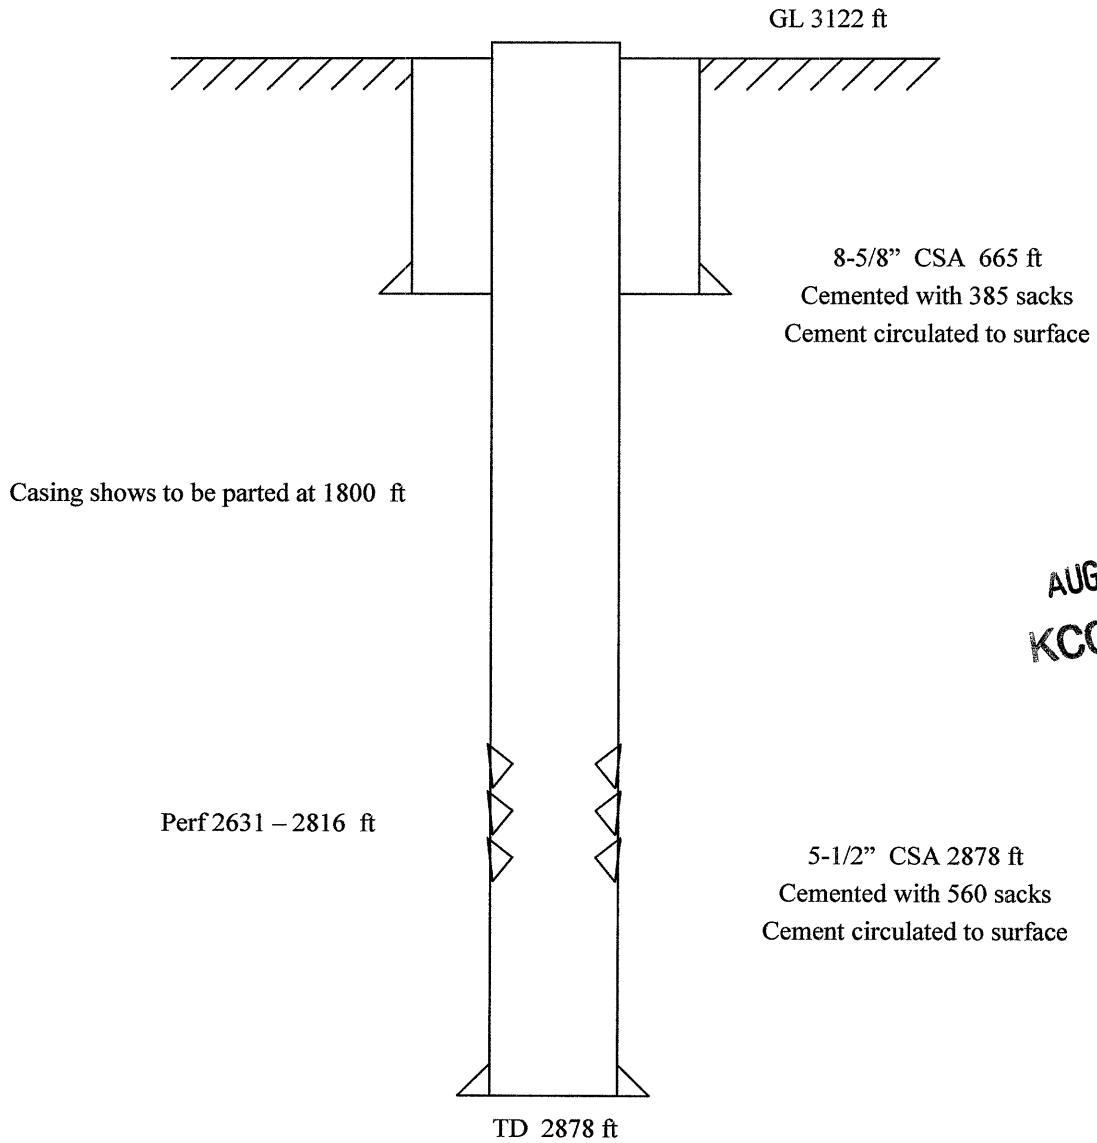

AUG 03
KCC WICHITA

Not to scale

R.R. Wilson B 2
Section 17, T28S, R38W
Council Grove Formation
Panoma Field
Grant County, Kansas

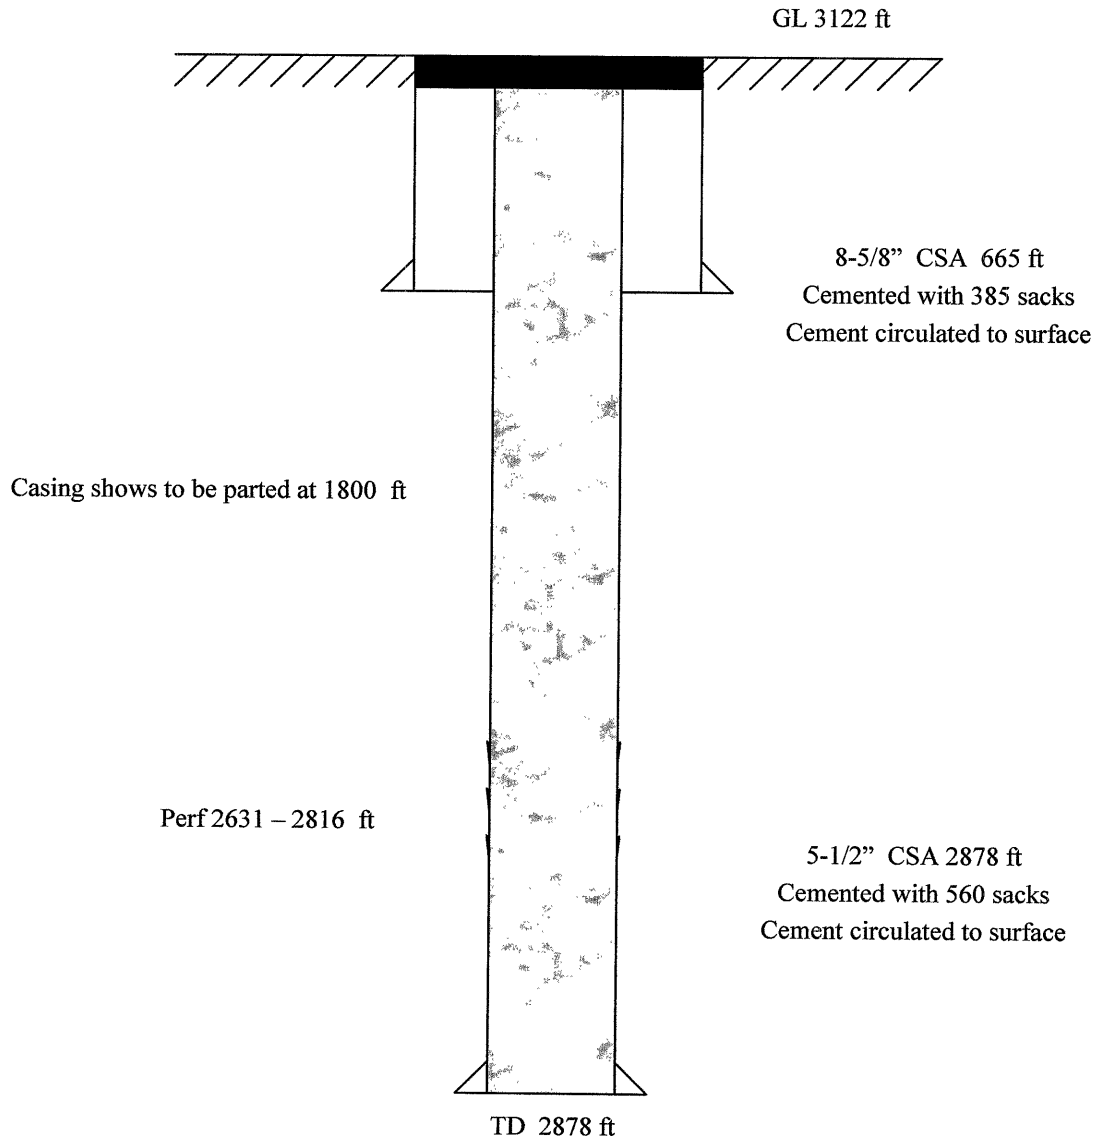

W-12
AUG 3 2006
KCC WICHITA

Not to scale



KANSAS

CORPORATION COMMISSION

Kathleen Sebelius, Governor Brian J. Moline, Chair Robert E. Krehbiel, Commissioner Michael C. Moffet, Commissioner

NOTICE OF RECEIPT OF WELL PLUGGING APPLICATION (CP-1)

BP America Production Company
2225 West Oklahoma Avenue
Ulysses, KS 67880

August 11, 2006

Re: R R WILSON B #2
API 15-067-20159-00-00
E2 17-28S-38W, 2470 FNL 1250 FEL
GRANT COUNTY, KANSAS

Dear Operator:

This letter is to notify you that the Conservation Division is in receipt of your plugging proposal, form CP-1, for the above-captioned well.


Your CP-1 has been reviewed by the Conservation Division central office for completeness and to verify license numbers. The plugging proposal will now be forwarded to the district office listed below for review of your proposed method of plugging.

Please contact the district office for approval of your proposed plugging method at least five (5) days before plugging the well, pursuant to K.A.R. 82-3-113 (b). If a workover pit will be used during the plugging of the well it must be permitted. A CDP-1 form must be filed and approved prior to the use of the pit.

The Conservation Division's review of form CP-1, either in the central or district office, does not include an inquiry into well ownership or the filing operator's legal right to plug the well.

This notice in no way constitutes authorization to plug the above-captioned well by persons not having legal rights of ownership or interest in the well. This notice is void after ninety (90) days from the above date.

Sincerely



David P. Williams
Production Supervisor

District: #1
210 E Frontview, Suite A
Dodge City, KS 67801
(620) 225-8888