

CARD MUST BE TYPED

State of Kansas

CARD MUST BE SIGNED

# NOTICE OF INTENTION TO DRILL

(see rules on reverse side)

Expected Spud Date..... 3 30 87  
month day year

API Number 15— 207-25,503-00-00

OPERATOR: License # 8036  
Name Bill's Oil Company  
Address Box 123  
City/State/Zip Lakeside, Oregon 97449  
Contact Person Bill Sowle  
Phone 503-759-4419

4th N.E. Sec 1 Sec. 5 Twp. 24 S, Rg. 16 East  
960 Ft. from South Line of Section  
1560 Ft. from East Line of Section

(Note: Locate well on Section Plat on reverse side)

CONTRACTOR: License # 5661  
Name Kelly Down Drilling Co., Inc.  
City/State Neosho Falls, Ks. 66758

Nearest lease or unit boundary line 960 feet  
County Woodson  
Lease Name Newby Well # 6

Well Drilled For: Well Class: Type Equipment:  
 Oil  Storage  Infield  Mud Rotary  
 Gas  Inj  Pool Ext.  Air Rotary  
 OWWO  Expl  Wildcat  Cable

Ground surface elevation ..... feet MSL  
Domestic well within 330 feet:  yes  no  
Municipal well within one mile:  yes  no  
Depth to bottom of fresh water.....  
Depth to bottom of usable water 150  
Surface pipe by Alternate: 1 2

If OWWO: old well info as follows:  
Operator .....  
Well Name .....  
Comp Date ..... Old Total Depth.....

Surface pipe planned to be set 40'  
Conductor pipe required  
Projected Total Depth 1050 feet  
Formation Squirrel

I certify that well will comply with K.S.A. 55-101, et seq., plus eventually plugging hole to KCC specifications.  
Date 3/12/87 Signature of Operator or Agent Regina Layman Title Agt.

For KCC Use:  
Conductor Pipe Required ..... feet; Minimum Surface Pipe Required 40 feet per Alt. 4 2  
This Authorization Expires 9-13-87 Approved By 3-13-87


*[Handwritten Signature]*

Must be filed with the K.C.C. five (5) days prior to commencing well  
 This card void if drilling not started within six (6) months of date received by K.C.C.

**Important procedures to follow:**

1. Notify District office before setting surface casing.
2. Set surface casing by circulating cement to the top.
3. File completion forms ACO-1 with K.C.C. within 120 days of well spud date, following instructions on ACO-1, side 1, and including copies of wireline logs.
4. Notify District office 48 hours prior to old well workover or re-entry.  
 Prior to filing Intent, prepare a proposed plugging plan in case well is D & A, then obtain approval of plan when calling district office prior to setting surface pipe.
5. Submit plugging report (CP-4) to K.C.C. after plugging is completed.
7. Obtain an approved injection docket number before disposing of salt water.
8. Notify K.C.C. within 10 days when injection commences or terminates.
9. If an alternate 2 completion, cement in the production pipe from below any usable water to surface within 120 days of spud date.

**A Regular Section of Land  
 1 Mile = 5,280 Ft.**

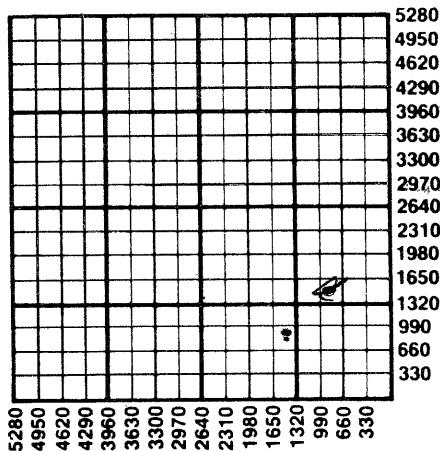

STATE CORPORATION COMMISSION

MAR 13 1987

CONSERVATION DIVISION  
 Wichita, Kansas

State Corporation Commission of Kansas  
 Conservation Division  
 200 Colorado Derby Building  
 Wichita, Kansas 67202-1212  
 (316) 263-3238