

CARD MUST BE SIGNED

121-26, 410-20-9

NW NE SW Sec 19 Twp 17 S, Rge 25 ☒ East
(location) ☐ West

Phone913-294-2125.....

City/State Paola, KS 66071.....

..2475..... Ft North from Southeast Corner of Section
 ..3795..... Ft West from Southeast Corner of Section
 (Note: Locate well on Section Plat on reverse side)

Nearest lease or unit boundary line 165 feet.

County Miami

Lease Name Kohlenberg Well# 5 E

Domestic well within 330 feet : ☐ yes ☒ no

Municipal well within one mile : ☐ yes ☒ no

Depth to Bottom of fresh water 22 feet

Lowest usable water formation

Depth to Bottom of usable water 300 feet

Surface pipe by Alternate : 1 ☐ 2 ☒

Surface pipe to be set 20 feet

Conductor pipe if any requirednone..... feet

Ground surface elevation feet MSL

This Authorization Expires 5-2-85

Approved By 11-1-84 *[Signature]*

☐ **OWWO** ☐ **Expl** ☐ **Wildcat** ☐ **Cable**

If OWWO: old well info as follows:

Operator

Well Name

Comp Date **Old Total Depth**

Projected Total Depth 700 feet

Projected Formation at TD Bartlesville

Expected Producing Formations Bartlesville

I certify that we will comply with K.S.A. 55-101, et seq., plus eventually plugging hole to K.C.C. specifications.

Date 10-22-84 Signature of Operator or Agent Donna Bamhart Title Agent

Must be filed with the K.C.C. five (5) days prior to commencing well
This card void if drilling not started within six (6) months of date received by K.C.C.


RECEIVED
STATE CORPORATION COMMISSION

Important procedures to follow:

NOV 01 1984

CONSERVATION DIVISION
Wichita, Kansas

**A Regular Section of Land
1 Mile = 5,280 Ft.**

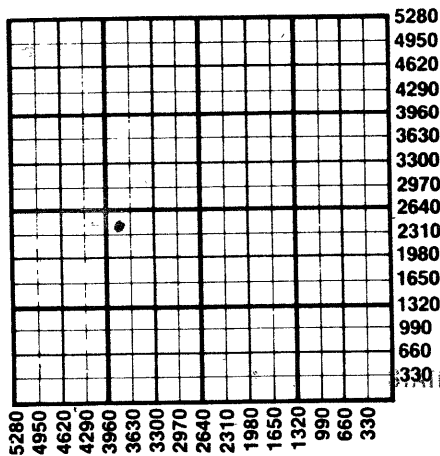

1. Notify District office before setting surface casing.
2. Set surface casing by circulating cement to the top.
3. File completion forms ACO-1 with K.C.C. within 90 days of well completion, following instructions on ACO-1, side 1, and including copies of wireline logs.
4. Notify District office 48 hours prior to old well workover or re-entry.
5. Prior to plugging, prepare a plugging plan, then obtain agreement from the appropriate district office for an approved plugging plan.
6. Submit plugging report (CP-4) to K.C.C. after plugging is completed.
7. Obtain an approved injection docket number before disposing of salt water.
8. Notify K.C.C. within 10 days when injection commences or terminates.
9. If an alternate 2 completion, cement in the production pipe from below any usable water to surface within 120 days of spud date.

RECEIVED

STATE CORPORATION COMMISSION

OCT 26 1984

CONSERVATION DIVISION
Wichita, Kansas

State Corporation Commission of Kansas
Conservation Division
200 Colorado Derby Building
Wichita, Kansas 67202
(316) 263-3238