

CARD MUST BE TYPED

State of Kansas NOTICE OF INTENTION TO DRILL

(see rules on reverse side)

CARD MUST BE SIGNED

Starting Date: 10 31 84
month day year

OPERATOR: License # 6142
Name Town Oil Co.
Address Route 4
City/State/Zip Paola, KS 66071
Contact Person Lester Town
Phone 913-2942125

CONTRACTOR: License # 6142
Name Town Oil Co.
City/State Paola, KS 66071

Well Drilled For: Well Class: Type Equipment:

☒ Oil ☐ Swd ☒ Infield ☒ Mud Rotary
☐ Gas ☐ Inj ☐ Pool Ext. ☐ Air Rotary
☐ OWWO ☐ Expl ☐ Wildcat ☐ Cable

If OWWO: old well info as follows:

Operator
Well Name
Comp Date Old Total Depth
Projected Total Depth 700 feet
Projected Formation at TD Bartlesville
Expected Producing Formations Bartlesville

API Number 15- 121-26,401-00-00
NW NE NW Sec 21 Twp 17 S, Rge 25 East
(location) ☐ West

5115 Ft North from Southeast Corner of Section
3795 Ft West from Southeast Corner of Section
(Note: Locate well on Section Plat on reverse side)

Nearest lease or unit boundary line 165 feet.
County Miami
Lease Name Bauer Well# 6

Domestic well within 330 feet: ☐ yes ☒ no
Municipal well within one mile: ☐ yes ☒ no

Depth to Bottom of fresh water 0 feet
Lowest usable water formation Kansas City Group
Depth to Bottom of usable water 300 feet
Surface pipe by Alternate: 1 ☐ 2 ☒
Surface pipe to be set 20 feet
Conductor pipe if any required none feet
Ground surface elevation feet MSL
This Authorization Expires 4-26-85
Approved By 10-26-84 PC

I certify that we will comply with K.S.A. 55-101, et seq., plus eventually plugging hole to K.C.C. specifications.


Date 10-22-84 Signature of Operator or Agent Donna Barnhart Title Agent Form C-1 4/84

MHC/KDHE 10/26/84

Must be filed with the K.C.C. five (5) days prior to commencing well
This card void if drilling not started within six (6) months of date received by K.C.C.

Important procedures to follow :

**A Regular Section of Land
1 Mile = 5,280 Ft.**

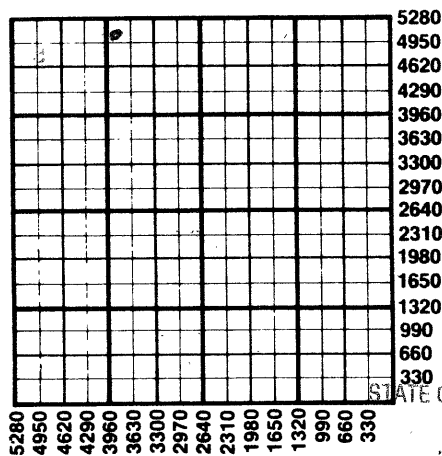

1. Notify District office before setting surface casing.
2. Set surface casing by circulating cement to the top.
3. File completion forms ACO-1 with K.C.C. within 90 days of well completion, following instructions on ACO-1, side 1, and including copies of wireline logs.
4. Notify District office 48 hours prior to old well workover or re-entry.
5. Prior to plugging, prepare a plugging plan, then obtain agreement from the appropriate district office for an approved plugging plan.
6. Submit plugging report (CP-4) to K.C.C. after plugging is completed.
7. Obtain an approved injection docket number before disposing of salt water.
8. Notify K.C.C. within 10 days when injection commences or terminates.
9. If an alternate 2 completion, cement in the production pipe from below any usable water to surface within 120 days of spud date.

RECEIVED
STATE CORPORATION COMMISSION

OCT 26 1984
10-26-84
CONSERVATION DIVISION
Wichita, Kansas

**State Corporation Commission of Kansas
Conservation Division
200 Colorado Derby Building
Wichita, Kansas 67202
(316) 263-3238**