CARD MUST BE TYPED

State of Kansas

NOTICE OF INTENTION TO DRILL

(see rules on reverse side)

CARD MUST BE SIGNED

Starting Date ..... month day year

API Number 15— 121-26,726-00-00

OPERATOR: License # 6142

Name Town Oil Co.

Address Rt. 4

City/State/Zip Paola, KS. 66071

Contact Person. Lester Town

Phone 913 294-2125

CONTRACTOR: License # 6142

Name COMPANY TOOLS

City/State

NW Sec. 21 Twp. 17 S, Rg. 25 X East ___ West

4785 Ft. from South Line of Section

3465 Ft. from East Line of Section

(Note: Locate well on Section Plat on reverse side)

Nearest lease or unit boundary line 495 feet

County Miami

Lease Name Bauer Well # 5

Ground surface elevation ..... feet MSL

Domestic well within 330 feet: ___ yes X no

Municipal well within one mile: ___ yes X no

Depth to bottom of fresh water. 30 ~~200~~

Depth to bottom of usable water 300

Surface pipe by Alternate: 1 ___ 2 XX

Surface pipe planned to be set 20

Conductor pipe required none

Projected Total Depth 700 feet

Formation Bartlesville

Well Drilled For:		Well Class:	Type Equipment:
/ Oil	___ SWD	/ Infield	/ Mud Rotary
___ Gas	___ Inj	___ Pool Ext.	___ Air Rotary
___ OWWO	___ Expl	___ Wildcat	___ Cable

If OWWO: old well info as follows:

Operator

Well Name

Comp Date ..... Old Total Depth.....

I certify that well will comply with K.S.A. 55-101, et seq., plus eventually plugging hole to KCC specifications.

Date 1-24-86 Signature of Operator or Agent Lester Town Title Partner

feet/KWK


For KCC Use:

Conductor Pipe Required ..... feet; Minimum Surface Pipe Required 20 feet per Alt. X (2)

This Authorization Expires 7-29-86 Approved By 1-29-86

Must be filed with the K.C.C. five (5) days prior to commencing well
This card void if drilling not started within six (6) months of date received by K.C.C.

A Regular Section of Land
1 Mile = 5,280 Ft.

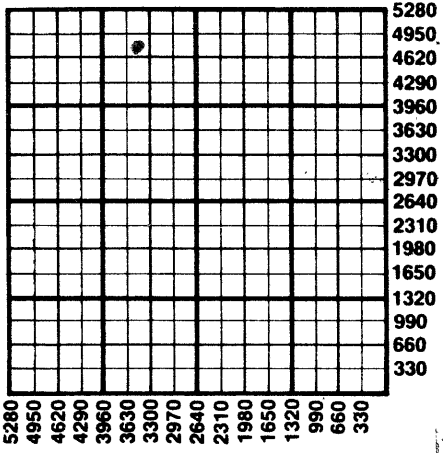

Important procedures to follow:

1. Notify District office before setting surface casing.
2. Set surface casing by circulating cement to the top.
3. File completion forms ACO-1 with K.C.C. within 90 days of well completion, following instructions on ACO-1, side 1, and including copies of wireline logs.
4. Notify District office 48 hours prior to old well workover or re-entry.
5. Prior to filing Intent, prepare a proposed plugging plan in case well is D & A, then obtain approval of plan when calling district office prior to setting surface pipe.
6. Submit plugging report (CP-4) to K.C.C. after plugging is completed.
7. Obtain an approved injection docket number before disposing of salt water.
8. Notify K.C.C. within 10 days when injection commences or terminates.
9. If an alternate 2 completion, cement in the production pipe from below any usable water to surface within 120 days of spud date.

RECEIVED
STATE CORPORATION COMMISSION
JAN 29 1985
CONSERVATION DIVISION

State Corporation Commission of Kansas
Conservation Division
200 Colorado Derby Building
Wichita, Kansas 67202
(316) 263-3238