

CARD MUST BE TYPED

State of Kansas

CARD MUST BE SIGNED

NOTICE OF INTENTION TO DRILL

(see rules on reverse side)

Starting Date Nov 14 1985 month day year

API Number 15- 207-25,416-00-00

OPERATOR: License # 9430 Name CMT Petro Resources Inc. Address R.R. 2 Box 149 City/State/Zip Canton Mo. 63435 Contact Person Steve Slater Phone 316 625 2983

SW4 SW4 Sec. 29 Twp. 23 S, Rg. 15 East 1000 Ft. from South Line of Section 3000 Ft. from East Line of Section

(Note: Locate well on Section Plat on reverse side)

CONTRACTOR: License # 9430 Name CMT Petro Resources Inc. City/State Canton, Mo. 63435

Nearest lease or unit boundary line 1000 feet County Woodson Lease Name #2 Stockbrand Well # 4

Well Drilled For: Oil SWD Infield Mud Rotary Gas Inj Pool Ext Air Rotary OWWO Expl Wildcat Cable

Ground surface elevation feet MSL Domestic well within 330 feet: yes no Municipal well within one mile: yes no Surface pipe by Alternate: 240 Unknown 1 2 Depth to bottom of fresh water: 150 Depth to bottom of usable water: 40 Surface pipe planned to be set Projected Total Depth 1550 feet Formation Mississippi

If OWWO: old well info as follows: Operator Well Name Comp Date Old Total Depth

I certify that well will comply with K.S.A. 55-101, et seq., plus eventually plugging hole to KCC specifications.

Date Nov 7 1985 Signature of Operator or Agent Steve Slater Title Supervisor


For KCC Use: Conductor Pipe Required feet; Minimum Surface Pipe Required feet per Alt 1 2 This Authorization Expires 5-12-86 Approved By 11-12-85 R

Must be filed with the K.C.C. five (5) days prior to commencing well
This card void if drilling not started within six (6) months of date received by K.C.C.

Important procedures to follow:

1. Notify District office before setting surface casing.
2. Set surface casing by circulating cement to the top.
3. File completion forms ACO-1 with K.C.C. within 90 days of well completion, following instructions on ACO-1, side 1, and including copies of wireline logs.
4. Notify District office 48 hours prior to old well workover or re-entry.
5. Prior to filing Intent, prepare a proposed plugging plan in case well is D & A, then obtain approval of plan when calling district office prior to setting surface pipe.
6. Submit plugging report (CP-4) to K. C. C. after plugging is completed.
7. Obtain an approved injection docket number before disposing of salt water.
8. Notify K.C.C. within 10 days when injection commences or terminates.

A Regular Section of Land 1 Mile = 5,280 Ft.

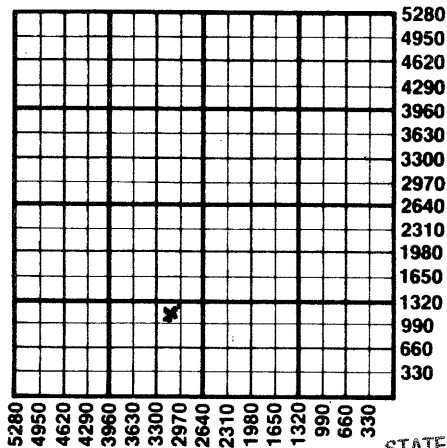

RECEIVED
STATE CORPORATION COMMISSION

NOV 2 1985
11-12-85
CONSERVATION DIVISION
Wichita, Kansas

...alternate 2 completion, cement in the production pipe from
below any usable water to surface within 120 days of spud date.

State Corporation Commission of Kansas
Conservation Division
200 Colorado Derby Building
Wichita, Kansas 67202
(316) 263-3238