

CARD MUST BE TYPED

State of Kansas

CARD MUST BE SIGNED

NOTICE OF INTENTION TO DRILL

(see rules on reverse side)

Starting Date Nov 20 1985
month day year

API Number 15— 207-25,417-0000
East

OPERATOR: License # ~~666~~ 9430
Name CMT Petro Resources Inc.
Address R.R. 2 Box 149
City/State/Zip Canton Mo. 63435
Contact Person, Steve Slater

SE4 SW4 Sec 29 Twp. 23 S, Rg. 15 West
200 Ft. from South Line of Section
3650 Ft. from East Line of Section

(Note: Locate well on Section Plat on reverse side)

Phone 316 625 2983
CONTRACTOR: License # 9430

Nearest lease or unit boundary line 200 feet
County Woodson
Lease Name # 2 Stockbrand Well # 5

Name CMT Petro Resources Inc.
City/State Canton Mo. 63435

Ground surface elevation feet MSL
Domestic well within 330 feet: _____ yes no
Municipal well within one mile: _____ yes no

Well Drilled For: Well Class: Type Equipment:
Oil SWD Infield Mud Rotary
Gas Inj Pool Ext. Air Rotary
OWWO Expl Wildcat Cable

Surface pipe by Alternate: 240 1 2
Depth to bottom of fresh water Unknown
Depth to bottom of usable water Unknown 150
Surface pipe planned to be set 40'
Projected Total Depth 850' feet
Formation Kansas City

If OWWO: old well info as follows:

Operator
Well Name
Comp Date Old Total Depth

I certify that well will comply with K.S.A. 55-101, et seq., plus eventually plugging hole to KCC specifications.

Date Nov/7/85 Signature of Operator or Agent Steve Slater Title Supervisor

For KCC Use:

Conductor Pipe Required feet; Minimum Surface Pipe Required feet per Alt. 1 2


This Authorization Expires 5-12-86 Approved By 11-12-85

Must be filed with the K.C.C. five (5) days prior to commencing well
 This card void if drilling not started within six (6) months of date received by K.C.C.

Important procedures to follow:

1. Notify District office before setting surface casing.
2. Set surface casing by circulating cement to the top.
3. File completion forms ACO-1 with K.C.C. within 90 days of well completion, following instructions on ACO-1, side 1, and including copies of wireline logs.
4. Notify District office 48 hours prior to old well workover or re-entry.
5. Prior to filing Intent, prepare a proposed plugging plan in case well is D & A, then obtain approval of plan when calling district office prior to setting surface pipe.
6. Submit plugging report (CP-4) to K. C. C. after plugging is completed.
7. Obtain an approved injection docket number before disposing of salt water.
8. Notify K.C.C. within 10 days when injection commences or terminates.
9. If an alternate 2 completion, cement in the production pipe from below any usable water to surface within 120 days of spud date.

**A Regular Section of Land
 1 Mile = 5,280 Ft.**

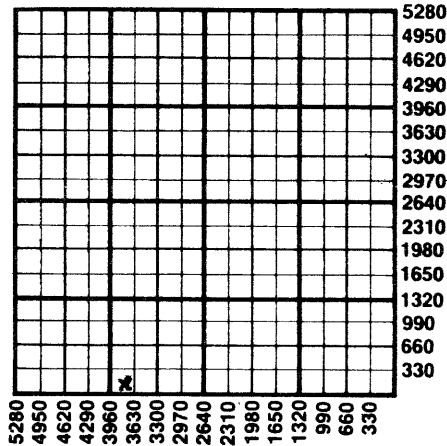

RECEIVED
 STATE CORPORATION COMMISSION
 NOV 11-12-85
 CONSERVATION DIVISION
 WICHITA, KANSAS

State Corporation Commission of Kansas
 Conservation Division
 200 Colorado Derby Building
 Wichita, Kansas 67202
 (316) 263-3238