

CARD MUST BE TYPED

State of Kansas

CARD MUST BE SIGNED

NOTICE OF INTENTION TO DRILL

(see rules on reverse side)

Starting Date April 6, 1987
month day year

API Number 15— 207-25506-0000
SW N W SE East

OPERATOR: License # 9430

~~SE NE SW~~ Sec. 29... Twp. 23.. S, Rg. 15.... ~~SW~~

Name CMT Petro Resources Inc.

1520 Ft. from South Line of Section

Address Rt 2 Box 149

2570 Ft. from East Line of Section

City/State/Zip Canton, MO 63435

(Note: Locate well on Section Plat on reverse side)

Contact Person Steve Slater

Phone 316-625-2983

Nearest lease or unit boundary line 200 feet

CONTRACTOR: License # 9430

County..... Woodson

Name Company Tools

Lease Name. Bowers..... Well #... 2.....

City/State

Ground surface elevation feet MSL

Well Drilled For: Well Class: Type Equipment:

Domestic well within 330 feet: ___yes Xno

X Oil ___ SWD X Infield X Mud Rotary

Municipal well within one mile: ___yes Xno

___ Gas ___ Inj ___ Pool Ext. ___ Air Rotary

Surface pipe by Alternate: 1 ___ 2 X ___

___ OWWO ___ Expl ___ Wildcat ___ Cable

Depth to bottom of fresh water... Unknown

If OWWO: old well info as follows:

Depth to bottom of usable water... 150

Operator

Surface pipe planned to be set ... 40",

Well Name

Projected Total Depth ... 1570 feet

Comp Date Old Total Depth.....

Formation Mississippi

I certify that well will comply with K.S.A. 55-101, et seq., plus eventually plugging hole to KCC specifications.

_____ cementing will be done immediately upon setting production casing.

Date 3-23-87 Signature of Operator or Agent Steve Slater

Title Supervisor

For KCC Use:

Conductor Pipe Required feet; Minimum Surface Pipe Required 40 feet per Alt. 4


This Authorization Expires 9-26-87 Approved By 3-26-87

Must be filed with the K.C.C. five (5) days prior to commencing well
 This card void if drilling not started within six (6) months of date received by K.C.C.

Important procedures to follow:

1. Notify District office before setting surface casing.
2. Set surface casing by circulating cement to the top.
3. File completion forms ACO-1 with K.C.C. within 90 days of well completion, following instructions on ACO-1, side 1, and including copies of wireline logs.
4. Notify District office 48 hours prior to old well workover or re-entry.
5. Prior to filing Intent, prepare a proposed plugging plan in case well is D & A, then obtain approval of plan when calling district office prior to setting surface pipe.
6. Submit plugging report (CP-4) to K. C. C. after plugging is completed.
7. Obtain an approved injection docket number before disposing of salt water.
8. Notify K.C.C. within 10 days when injection commences or terminates.
9. If an alternate 2 completion, cement in the production pipe from below any usable water to surface within 120 days of spud date.

A Regular Section of Land
 1 Mile = 5,280 Ft.

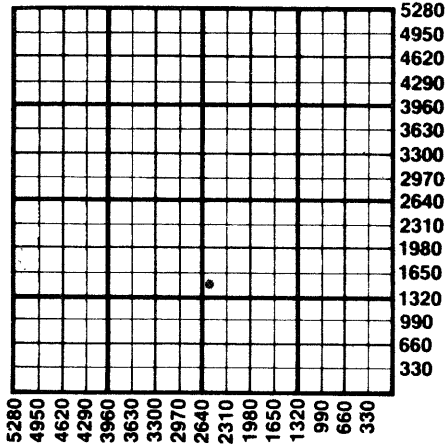

MAR 25 1987

3-25-87

State Corporation Commission of Kansas
 Conservation Division
 200 Colorado Derby Building
 Wichita, Kansas 67202
 (316) 263-3238