

CARD MUST BE TYPED

State of Kansas NOTICE OF INTENTION TO DRILL

(see rules on reverse side)

CARD MUST BE SIGNED

Starting Date: October 14, 1984
month day year

OPERATOR: License # 9036
Name Oakridge Enterprises
Address R.R. #1
City/State/Zip Yates Center, Ks. 66783
Contact Person Larry C. Martin
Phone 316-625-3334

CONTRACTOR: License # 9430
Name CMT Petro Resources Inc.
City/State Canton, Mo. 63435

Well Drilled For: Well Class: Type Equipment:

☒ Oil ☐ Swd ☐ Infield ☒ Mud Rotary
☐ Gas ☐ Inj ☐ Pool Ext. ☐ Air Rotary
☐ OWWO ☐ Expl ☒ Wildcat ☐ Cable

If OWWO: old well info as follows:

Operator

Well Name

Comp Date Old Total Depth

Projected Total Depth 1600 feet

Projected Formation at TD Mississippi

Expected Producing Formations Mississippi

API Number 15-

207-25,084-00-00

S64 NE4 Sec 33 Twp 23 S Rge 15 East
(location)

2815 Ft North from Southeast Corner of Section
910 1200 350 Ft West from Southeast Corner of Section
(Note: Locate well on Section Plat on reverse side)

Nearest lease or unit boundary line 175 feet.

County Woodson

Lease Name Reinking Well# 9

Domestic well within 330 feet: ☐ yes ☒ no

Municipal well within one mile: ☐ yes ☒ no

Depth to Bottom of fresh water Unknown feet

Lowest usable water formation Unknown

Depth to Bottom of usable water Unknown 150 feet

Surface pipe by Alternate: ☐ 1 ☒ 2

Surface pipe to be set 40 feet

Conductor pipe if any required none feet

Ground surface elevation 1080 feet MSL

This Authorization Expires 4-10-85

Approved By 10-10-84 RC


I certify that we will comply with K.S.A. 55-101, et seq., plus eventually plugging hole to K.C.C. specifications.

Date 10/3/84 Signature of Operator or Agent Ray C Martin Title operator

**Must be filed with the K.C.C. five (5) days prior to commencing well
This card void if drilling not started within six (6) months of date received by K.C.C.**

Important procedures to follow:

**A Regular Section of Land
1 Mile = 5,280 Ft.**

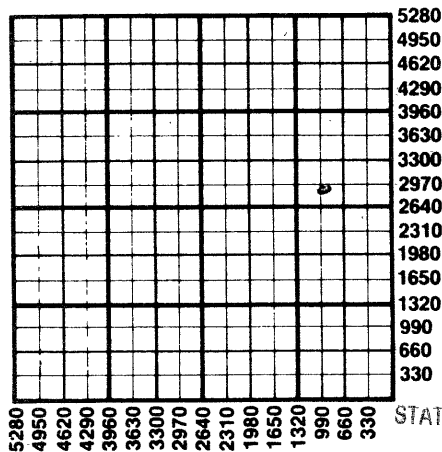

1. Notify District office before setting surface casing.
2. Set surface casing by circulating cement to the top.
3. File completion forms ACO-1 with K.C.C. within 90 days of well completion, following instructions on ACO-1, side 1, and including copies of wireline logs.
4. Notify District office 48 hours prior to old well workover or re-entry.
5. Prior to plugging, prepare a plugging plan, then obtain agreement from the appropriate district office for an approved plugging plan.
6. Submit plugging report (CP-4) to K.C.C. after plugging is completed.
7. Obtain an approved injection docket number before disposing of salt water.
8. Notify K.C.C. within 10 days when injection commences or terminates.
9. If an alternate 2 completion, cement in the production pipe from below any usable water to surface within 120 days of spud date.

RECEIVED
STATE CORPORATION COMMISSION

State Corporation Commission of Kansas
Conservation Division
200 Colorado Derby Building
Wichita, Kansas 67202
(316) 263-3238

OCT 10 1984
10-16-84
CONSERVATION DIVISION
Wichita, Kansas

RECEIVED
STATE CORPORATION COMMISSION

OCT 05 1984

Wichita, Kansas