

CARD MUST BE TYPED

State of Kansas
NOTICE OF INTENTION TO DRILL
(see rules on reverse side)

CARD MUST BE SIGNED

Starting Date:October 9, 1984.....
month day year

API Number 15- 207-25,085-00-00

OPERATOR: License # 9036
NameOakridge Enterprises.....
AddressR.R. # 1, Yates Center, Ks. 66783
City/State/Zip
Contact PersonLarry C. Martin.....
Phone ..316-625-3334.....

SW4 NE4. Sec. 33 Twp 23 S, Rge 15. . East
(location) West

CONTRACTOR: License # 9430
Name ...CMT Petro Resources Inc.....
City/State Canton, Mo. 63435.....

2815..... Ft North from Southeast Corner of Section
1675..... Ft West from Southeast Corner of Section
(Note: Locate well on Section Plat on reverse side)

Nearest lease or unit boundary line ..175..... feet.
County Woodson.....

Lease Name ...Reinking..... Well# 8.....

Domestic well within 330 feet : yes no

Municipal well within one mile : yes no

Well Drilled For: **Well Class:** **Type Equipment:**

Oil Swd Infield Mud Rotary
 Gas Inj Pool Ext. Air Rotary
 OWWO Expl Wildcat Cable

Depth to Bottom of fresh waterUnknown..... feet

Lowest usable water formationUnknown.....

Depth to Bottom of usable waterUnknown 150..... feet


Surface pipe by Alternate : 1 2

Surface pipe to be set40..... feet

Conductor pipe if any requirednone..... feet

Ground surface elevation1080..... feet MSL

This Authorization Expires 4-10-85

Approved By 10-10-84 


I certify that we will comply with K.S.A. 55-101, et seq., plus eventually plugging hole to K.C.C. specifications.

Date 10/3/84 Signature of Operator or Agent Larry C. Martin Title operator

**Must be filed with the K.C.C. five (5) days prior to commencing well
This card void if drilling not started within six (6) months of date received by K.C.C.**

Important procedures to follow :

**A Regular Section of Land
1 Mile = 5,280 Ft.**

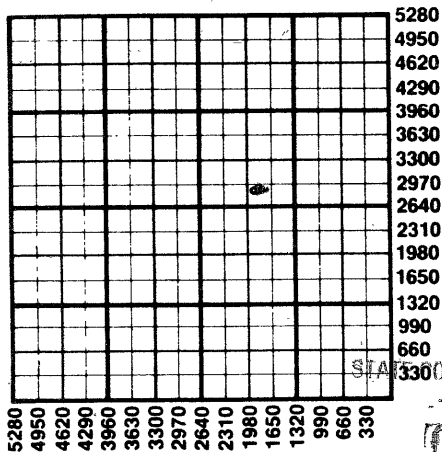

1. Notify District office before setting surface casing.
2. Set surface casing by circulating cement to the top.
3. File completion forms ACO-1 with K.C.C. within 90 days of well completion, following instructions on ACO-1, side 1, and including copies of wireline logs.
4. Notify District office 48 hours prior to old well workover or re-entry.
5. Prior to plugging, prepare a plugging plan, then obtain agreement from the appropriate district office for an approved plugging plan.
6. Submit plugging report (CP-4) to K.C.C. after plugging is completed.
7. Obtain an approved injection docket number before disposing of salt water.
8. Notify K.C.C. within 10 days when injection commences or terminates.
9. If an alternate 2 completion, cement in the production pipe from below any usable water to surface within 120 days of spud date.

RECEIVED
STATE CORPORATION COMMISSION

RECEIVED
STATE CORPORATION COMMISSION

OCT 10 1984

OCT 05 1984

CONSERVATION DIVISION
WICHITA, KANSAS
10-10-84

**State Corporation Commission of Kansas
Conservation Division
200 Colorado Derby Building
Wichita, Kansas 67202
(316) 263-3238**

Wichita, Kansas