

CARD MUST BE TYPED

State of Kansas
NOTICE OF INTENTION TO DRILL
 (see rules on reverse side)

CARD MUST BE SIGNED

Starting Date: August 31, 1984
 month day year

OPERATOR: License # 9036
 Oakridge Enterprises

Name R.R. # 1

Address Yates Center, Ks 66783

City/State/Zip Larry C. Martin

Contact Person 316-625-2232

Phone

CONTRACTOR: License # 9430

Name CMT Petro Resources, Inc.

City/State Canton, Mo. 63435

Well Drilled For: Well Class: Type Equipment:

☒ Oil ☐ Swd ☒ Infield ☒ Mud Rotary

☐ Gas ☐ Inj ☐ Pool Ext. ☐ Air Rotary

☐ OWWO ☐ Expl ☐ Wildcat ☐ Cable

If OWWO: old well info as follows:

Operator

Well Name

Comp Date Old Total Depth

Projected Total Depth 1175 feet

Projected Formation at TD Squirrel

Expected Producing Formations Squirrel

I certify that we will comply with K.S.A. 55-101, et seq., plus eventually plugging hole to K.C.C. specifications.

Date Aug. 31, 1984
 Signature of Operator or Agent

API Number 15-

207-25,030-0000

North one-half 33 Sec 23 S, Rge 15
 (location)

5105

Ft North from Southeast Corner of Section

5105

Ft West from Southeast Corner of Section

(Note: Locate well on Section Plat on reverse side)

Nearest lease or unit boundary line 330 feet.

County Woodson

Lease Name Reinking Well # 4

Domestic well within 330 feet: ☐ yes ☒ no

Municipal well within one mile: ☐ yes ☒ no

Depth to Bottom of fresh water Unknown feet

Lowest usable water formation Unknown

Depth to Bottom of usable water Unknown 150 feet

Surface pipe by Alternate: 1 ☐ 2 ☒

Surface pipe to be set 40' feet

Conductor pipe if any required None feet

Ground surface elevation 1080 feet MSL

This Authorization Expires 3-2-85

Approved By 8-30-84 R


Date Aug. 31, 1984
 Signature of Operator or Agent Larry C. Martin Title Owner

MHC/KOHE 8/30/84

Must be filed with the K.C.C. five (5) days prior to commencing well
This card void if drilling not started within six (6) months of date received by K.C.C.

Important procedures to follow :

A Regular Section of Land
1 Mile = 5,280 Ft.

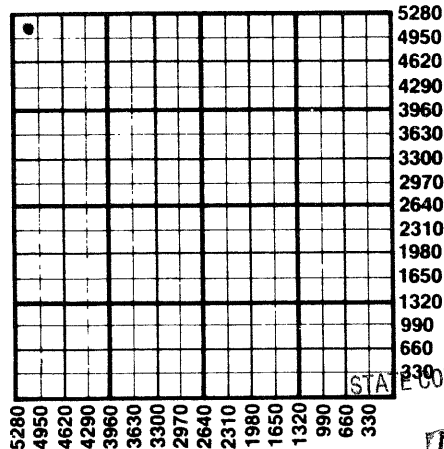

1. Notify District office before setting surface casing.
2. Set surface casing by circulating cement to the top.
3. File completion forms ACO-1 with K.C.C. within 90 days of well completion, following instructions on ACO-1, side 1, and including copies of wireline logs.
4. Notify District office 48 hours prior to old well workover or re-entry.
5. Prior to plugging, prepare a plugging plan, then obtain agreement from the appropriate district office for an approved plugging plan.
6. Submit plugging report (CP-4) to K.C.C. after plugging is completed.
7. Obtain an approved injection docket number before disposing of salt water.
8. Notify K.C.C. within 10 days when injection commences or terminates.
9. If completion 2 completion, cement in the production pipe from below any usable water to surface within 120 days of spud date.

RECEIVED
KANSAS
CORPORATION COMMISSION

AUG 30 1984

CONSERVATION DIVISION
Wichita, Kansas

8-30-84

State Corporation Commission of Kansas
Conservation Division
200 Colorado Derby Building
Wichita, Kansas 67202
(316) 263-3238