

CARD MUST BE TYPED

State of Kansas

CARD MUST BE SIGNED

NOTICE OF INTENTION TO DRILL

(see rules on reverse side)

Starting Date March 27 1986
month day year

API Number 15— 207-25,466-0000

OPERATOR: License # 9430
Name PETRO RESOURCES INC.
Address R R 2 BOX 149
City/State/Zip CANTON MO. 63435
Contact Person STEVE SLATER
Phone 316-625-2983

NE NW NW Sec. 33 Twp. 23 S, Rg. 15 East
_____ West
_____ Ft. from South Line of Section
_____ Ft. from East Line of Section

(Note: Locate well on Section Plat on reverse side)

CONTRACTOR: License # 8430
Name PETRO RESOURCES INC.
City/State CANTON MO. 63435

Nearest lease or unit boundary line 330 feet
County WOODSON
Lease Name REINKING WEST Well # 8
Ground surface elevation _____ feet MSL

Well Drilled For: Well Class: Type Equipment:
 Oil SWD Infield Mud Rotary
 Gas Inj Pool Ext. Air Rotary
 OWWO Expl Wildcat Cable

Domestic well within 330 feet: _____ yes no
Municipal well within one mile: _____ yes no
Surface pipe by Alternate: 1 _____ 2
Depth to bottom of fresh water 40
Depth to bottom of usable water 150
Surface pipe planned to be set 40!
Projected Total Depth 1175 feet
Formation SQUIRREL

If OWWO: old well info as follows:
Operator _____
Well Name _____
Comp Date _____ Old Total Depth _____

I certify that well will comply with K.S.A. 55-101, et seq., plus eventually plugging hole to KCC specifications.

 cementing will be done immediately upon setting production casing.
Date 20 March 86 Signature of Operator or Agent Steve Slater Title SUPERVISOR


For KCC Use:
Conductor Pipe Required _____ feet; Minimum Surface Pipe Required 40 feet per Alt. 2
This Authorization Expires 7-24-86 Approved By 3-24-86

Must be filed with the K.C.C. five (5) days prior to commencing well
This card void if drilling not started within six (6) months of date received by K.C.C.

Important procedures to follow:

1. Notify District office before setting surface casing.
2. Set surface casing by circulating cement to the top.
3. File completion forms ACO-1 with K.C.C. within 90 days of well completion, following instructions on ACO-1, side 1, and including copies of wireline logs.
4. Notify District office 48 hours prior to old well workover or re-entry.
5. Prior to filing Intent, prepare a proposed plugging plan in case well is D & A, then obtain approval of plan when calling district office prior to setting surface pipe.
6. Submit plugging report (CP-4) to K. C. C. after plugging is completed.
7. Obtain an approved injection docket number before disposing of salt water.
8. Notify K.C.C. within 10 days when injection commences or terminates.
9. If an alternate 2 completion, cement in the production pipe from below any usable water to surface within 120 days of spud date.

**A Regular Section of Land
1 Mile = 5,280 Ft.**

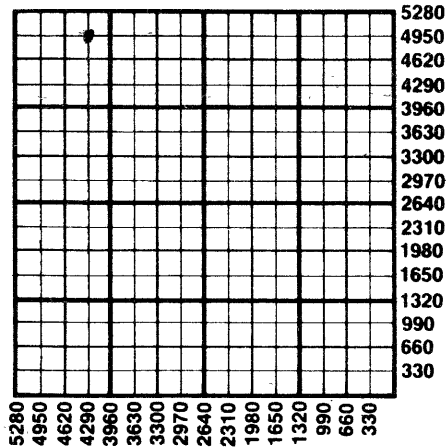

STATE CORPORATION COMMISSION

MAR 24 1985

CONSERVATION DIVISION
Wichita, Kansas

324-86

State Corporation Commission of Kansas
Conservation Division
200 Colorado Derby Building
Wichita, Kansas 67202
(316) 263-3238