

CARD MUST BE TYPED

State of Kansas
NOTICE OF INTENTION TO DRILL
(see rules on reverse side)

CARD MUST BE SIGNED

Starting Date: 9 27 84
month day year

API Number 15- 003-22,511-00-00

OPERATOR: License # 5499

N $\frac{1}{2}$ of NE $\frac{1}{4}$ Sec 34 Twp 21 S, Rge 19
(location) East West

Name Brecheisen Oil Company

Address Box 40

City/State/Zip Garnett, Kansas 66032

Contact Person A. W. Brecheisen

Phone 913-448-6952

4930 Ft North from Southeast Corner of Section

1016 Ft West from Southeast Corner of Section

(Note: Locate well on Section Plat on reverse side)

CONTRACTOR: License # 6102

Nearest lease or unit boundary line 1016 feet.

County Anderson

Name Hastert Drilling Company

Lease Name Kellstadt Well# 3 I 84

City/State Garnett, Kansas 66032

Domestic well within 330 feet: yes no

Municipal well within one mile: yes no

Well Drilled For: Well Class: Type Equipment:

- | | | | |
|-------------------------------|---|---|--|
| <input type="checkbox"/> Oil | <input type="checkbox"/> Swd | <input checked="" type="checkbox"/> Infield | <input checked="" type="checkbox"/> Mud Rotary |
| <input type="checkbox"/> Gas | <input checked="" type="checkbox"/> Inj | <input type="checkbox"/> Pool Ext. | <input type="checkbox"/> Air Rotary |
| <input type="checkbox"/> OWWO | <input type="checkbox"/> Expl | <input type="checkbox"/> Wildcat | <input type="checkbox"/> Cable |

Depth to Bottom of fresh water none feet

Lowest usable water formation

Depth to Bottom of usable water 125 feet

Surface pipe by Alternate: 1 2

Surface pipe to be set 21 feet

Conductor pipe if any required none feet

Ground surface elevation

This Authorization Expires 3-24-85

Approved By 9-24-84 R

If OWWO: old well info as follows:

Operator

Well Name

Comp Date Old Total Depth

Projected Total Depth 860 feet

Projected Formation at TD Squirrel

Expected Producing Formations

I certify that we will comply with K.S.A. 55-101, et seq., plus eventually plugging hole to K.C.C. specifications.

Date 9-20-84 Signature of Operator or Agent

Louis Ulsen

Title Office Manager


Form C-1 4/84

MHC/KOHE 9/24/84

**Must be filed with the K.C.C. five (5) days prior to commencing well
This card void if drilling not started within six (6) months of date received by K.C.C.**

Important procedures to follow :

**A Regular Section of Land
1 Mile = 5,280 Ft.**

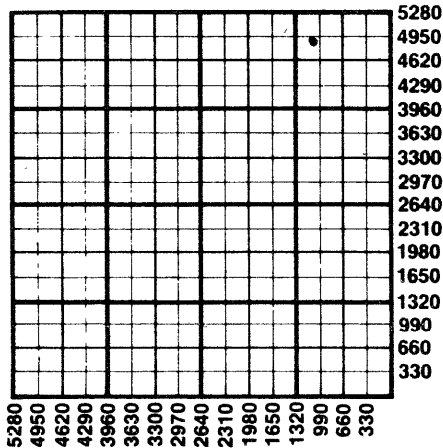

1. Notify District office before setting surface casing.
2. Set surface casing by circulating cement to the top.
3. File completion forms ACO-1 with K.C.C. within 90 days of well completion, following instructions on ACO-1, side 1, and including copies of wireline logs.
4. Notify District office 48 hours prior to old well workover or re-entry.
5. Prior to plugging, prepare a plugging plan, then obtain agreement from the appropriate district office for an approved plugging plan.
6. Submit plugging report (CP-4) to K.C.C. after plugging is completed.
7. Obtain an approved injection docket number before disposing of salt water.
8. Notify K.C.C. within 10 days when injection commences or terminates.
9. If an alternate 2 completion, cement in the production pipe from below any usable water to surface within 120 days of spud date.

RECEIVED
STATE CORPORATION COMMISSION

SEP 24 1984
9-24-84
CONSERVATION DIVISION
Wichita, Kansas

State Corporation Commission of Kansas
Conservation Division
200 Colorado Derby Building
Wichita, Kansas 67202
(316) 263-3238