

CARD MUST BE TYPED

State of Kansas NOTICE OF INTENTION TO DRILL

(see rules on reverse side)

CARD MUST BE SIGNED

Starting Date: 1 27 86
month day year

OPERATOR: License # 5499
Name BRECHEISEN OIL COMPANY
Address BOX 40
City/State/Zip GARNETT, KANSAS 66032
Contact Person A W Brecheisen
Phone 913-448-6952

CONTRACTOR: License # 6102
Name HASTERT OIL CO.
City/State GARNETT, KANSAS 66032

Well Drilled For:	Well Class:	Type Equipment:
☒ Oil ☐ Swd	☒ Infield	☒ Mud Rotary
☐ Gas ☐ Inj	☐ Pool Ext.	☐ Air Rotary
☐ OWWO ☐ Expl	☐ Wildcat	☐ Cable

If OWWO: old well info as follows:

Operator
Well Name
Comp Date Old Total Depth
Projected Total Depth feet
Projected Formation at TD
Expected Producing Formations

I certify that we will comply with K.S.A. 55-101, et seq., plus eventually plugging hole to K.C.C. specifications.

Date 1-20-86 Signature of Operator or Agent

API Number 15- 003-22,729-00-00
S $\frac{1}{2}$ NW NW Sec 34 Twp 21 S, Rge 19 ☒ East
(location) ☐ West

4290 Ft North from Southeast Corner of Section
660 Ft West from Southeast Corner of Section
(Note: Locate well on Section Plat on reverse side)

Nearest lease or unit boundary line 990 feet.
County Anderson
Lease Name Kellstadt Well # 1 P 86

Domestic well within 330 feet: ☐ yes ☒ no
Municipal well within one mile: ☐ yes ☒ no


Depth to Bottom of fresh water 80 feet
Lowest usable water formation
Depth to Bottom of usable water 125 feet
Surface pipe by Alternate: 1 ☐ 2 ☒
Surface pipe to be set 20 feet
Conductor pipe if any required none feet
Ground surface elevation feet MSL
This Authorization Expires 7-23-86
Approved By 1-23-86

Office Manager

**Must be filed with the K.C.C. five (5) days prior to commencing well
This card void if drilling not started within six (6) months of date received by K.C.C.**

Important procedures to follow :

**A Regular Section of Land
1 Mile = 5,280 Ft.**

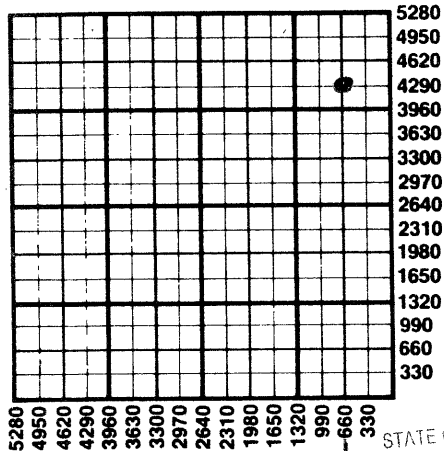

1. Notify District office before setting surface casing.
2. Set surface casing by circulating cement to the top.
3. File completion forms ACO-1 with K.C.C. within 90 days of well completion, following instructions on ACO-1, side 1, and including copies of wireline logs.
4. Notify District office 48 hours prior to old well workover or re-entry.
5. Prior to plugging, prepare a plugging plan, then obtain agreement from the appropriate district office for an approved plugging plan.
6. Submit plugging report (CP-4) to K.C.C. after plugging is completed.
7. Obtain an approved injection docket number before disposing of salt water.
8. Notify K.C.C. within 10 days when injection commences or terminates.
9. If an alternate 2 completion, cement in the production pipe from below any usable water to surface within 120 days of spud date.

STATE CORPORATION COMMISSION

JAN 25 1986
01-23-86
CONSERVATION DIVISION
WICHITA, KANSAS

**State Corporation Commission of Kansas
Conservation Division
200 Colorado Derby Building
Wichita, Kansas 67202
(316) 263-3238**