

CARD MUST BE TYPED

NOTICE OF INTENTION TO DRILL

State of Kansas
(see rules on reverse side)

CARD MUST BE SIGNED

Starting Date: Dec. 22, 1985
month day year

API Number 15- 207-25,418 00-00

OPERATOR: License # 6443

SE $\frac{1}{4}$ East
..... Sec. 29 Twp. 23, Rge. 16 West
(location)

Name Lewis Long

Address Box 110 Hamilton, Kansas 66853

City/State/Zip

Contact Person Lewis Long

Phone 316 678 3819

..... 900 Ft North from Southeast Corner of Section
..... 2310 Ft West from Southeast Corner of Section
(Note: Locate well on Section Plat on reverse side)

CONTRACTOR: License # 5676

Name EDCO Drilling Co., Inc.

City/State Box 645 El Dorado, Kansas 67042

Nearest lease or unit boundary line 330 feet.

County Woodson

Lease Name Robinson Well# 18

Domestic well within 330 feet : yes no

Municipal well within one mile : yes no

Well Drilled For: Well Class: Type Equipment:

- Oil Swd Infield Mud Rotary
- Gas Inj Pool Ext. Air Rotary
- OWWO Expl Wildcat Cable

Depth to Bottom of fresh water 40 feet

Lowest usable water formation 40 feet

Depth to Bottom of usable water 40/50 feet

Surface pipe by Alternate : 1 2

Surface pipe to be set 40 feet

Conductor pipe if any required 1116 feet

Ground surface elevation 1116 feet MSL

This Authorization Expires 6-13-86

Approved By 12-13-85

If OWWO: old well info as follows:

Operator

Well Name

Comp Date Old Total Depth

Projected Total Depth 4,100 feet

Projected Formation at TD

Expected Producing Formations

I certify that we will comply with K.S.A. 55-101, et seq., plus eventually plugging hole to K.C.C. specifications.

Date Dec. 12, 1985
Signature of Operator or Agent

Lewis C. Long


Title CO OWNER

RCR/DAE

**Must be filed with the K.C.C. five (5) days prior to commencing well
This card void if drilling not started within six (6) months of date received by K.C.C.**

Important procedures to follow :

**A Regular Section of Land
1 Mile = 5,280 Ft.**

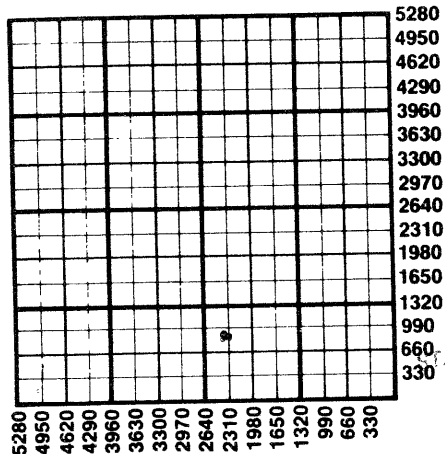

1. Notify District office before setting surface casing.
2. Set surface casing by circulating cement to the top.
3. File completion forms ACO-1 with K.C.C. within 90 days of well completion, following instructions on ACO-1, side 1, and including copies of wireline logs.
4. Notify District office 48 hours prior to old well workover or re-entry.
5. Prior to plugging, prepare a plugging plan, then obtain agreement from the appropriate district office for an approved plugging plan.
6. Submit plugging report (CP-4) to K.C.C. after plugging is completed.
7. Obtain an approved injection docket number before disposing of salt water.
8. Notify K.C.C. within 10 days when injection commences or terminates.
9. If an alternate 2nd completion, cement in the production pipe from below any usable water to surface within 120 days of spud date.

DEC 13 1985
 CONSERVATION DIVISION
 Wichita, Kansas
 12-13-85

**State Corporation Commission of Kansas
 Conservation Division
 200 Colorado Derby Building
 Wichita, Kansas 67202
 (316) 263-3238**