

CARD MUST BE TYPED

State of Kansas
NOTICE OF INTENTION TO DRILL
 (see rules on reverse side)

CARD MUST BE SIGNED

Starting Date: 1 7 84
 month day year

OPERATOR: License # 9967
 Name Suyen Enterprises
 Address 432 Bergen Boulevard
 City/State/Zip Ridgefield, NJ 07657
 Contact Person Mark Richard
 Phone 316-431-2080

CONTRACTOR: License #
 Name Contractor unknown
 City/State

Well Drilled For: Well Class: Type Equipment:

☒ Oil ☐ Swd ☐ Infield ☐ Mud Rotary
☐ Gas ☐ Inj ☐ Pool Ext. ☐ Air Rotary
☐ OWWO ☐ Expl ☐ Wildcat ☐ Cable

If OWWO: old well info as follows:

Operator
 Well Name
 Comp Date Old Total Depth
 Projected Total Depth 1400 feet
 Projected Formation at TD Mississippian
 Expected Producing Formations Squirrel

I certify that we will comply with K.S.A. 55-101, et seq., plus eventually plugging hole to K.C.C. specifications.

Date 1-2-84 Signature of Operator or Agent

API Number 15-

207-25,19300-00

SE/4 Sec 19 Twp 23 S, Rge 17 ☒ East
 (location) ☐ West

2250 Ft North from Southeast Corner of Section
2060 Ft West from Southeast Corner of Section
 (Note: Locate well on Section Plat on reverse side)

Nearest lease or unit boundary line 350 feet.

County Woodson

Lease Name Schockley Well# 16

Domestic well within 330 feet: ☐ yes ☒ no

Municipal well within one mile: ☐ yes ☒ no

Depth to Bottom of fresh water feet

Lowest usable water formation feet

Depth to Bottom of usable water 150 feet

Surface pipe by Alternate: 1 ☐ 2 ☒ 20

Surface pipe to be set feet

Conductor pipe if any required feet

Ground surface elevation feet MSL

This Authorization Expires 7-3-85


Approved By 1-3-85 RE

Date 1-2-84 Signature of Operator or Agent Mark Richard Title Agent

Must be filed with the K.C.C. five (5) days prior to commencing well
This card void if drilling not started within six (6) months of date received by K.C.C.

Important procedures to follow :

A Regular Section of Land
1 Mile = 5,280 Ft.

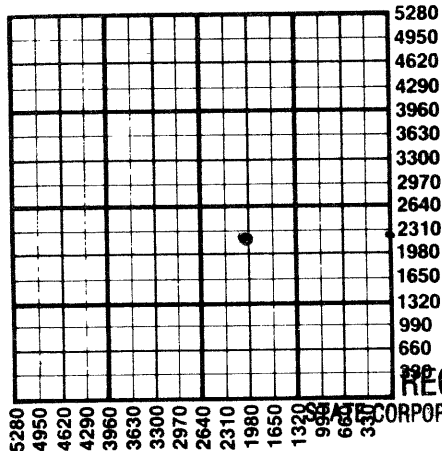

1. Notify District office before setting surface casing.
2. Set surface casing by circulating cement to the top.
3. File completion forms ACO-1 with K.C.C. within 90 days of well completion, following instructions on ACO-1, side 1, and including copies of wireline logs.
4. Notify District office 48 hours prior to old well workover or re-entry.
5. Prior to plugging, prepare a plugging plan, then obtain agreement from the appropriate district office for an approved plugging plan.
6. Submit plugging report (CP-4) to K.C.C. after plugging is completed.
7. Obtain an approved injection docket number before disposing of salt water.
8. Notify K.C.C. within 10 days when injection commences or terminates.
9. If an alternate 2 completion, cement in the production pipe from below any usable water to surface within 120 days of spud date.

RECEIVED
STATE CORPORATION COMMISSION
JAN 03 1985
1-3-85
CONSERVATION DIVISION
Wichita, Kansas

State Corporation Commission of Kansas
Conservation Division
200 Colorado Derby Building
Wichita, Kansas 67202
(316) 263-3238