

CARD MUST BE TYPED

State of Kansas

CARD MUST BE SIGNED

NOTICE OF INTENTION TO DRILL

(see rules on reverse side)

1/1A

Starting Date Dec. 20/87 month day year

API Number 15- 207-25,546-00-00 SE SW X East

OPERATOR: License # 4671 BICOLI COMPANY

Sec. 22 Twp. 23 S, Rg. 17

Name Rt. 3

165 Ft. from South Line of Section 4125 Ft. from East Line of Section

Address Iola, Kansas 66749

(Note: Locate well on Section Plat on reverse side)

Contact Person Bill D. Haas

Nearest lease or unit boundary line 165 feet County: Woodsan

Phone 1-316-496-2692

CONTRACTOR: License # Haul-Pac, Inc. No. 6553

Lease Name: Bedenbender Well #: OP 101 Ground surface elevation 970 feet MSL

Name Humboldt, Kansas 66748

Well Drilled For: X Oil SWD X Infield X Mud Rotary Pool Ext. Air Rotary Wildcat Cable

Domestic well within 330 feet: yes X no Municipal well within one mile: yes X no Depth to bottom of fresh water 100 ft. Depth to bottom of usable water 150 100 ft. Surface pipe by Alternate: 1 2 X

If OWWO: old well info as follows: Operator BXXXXDXXXXX Well Name ##### Comp Date Old Total Depth

Surface pipe planned to be set 40 ft. Conductor pipe required 20 ft. Projected Total Depth 900 feet Formation Squirrel

I certify that well will comply with K.S.A. 55-101, et seq., plus eventually plugging hole to KCC specifications. Date 12-12-87 Signature of Operator or Agent Bill D. Haas Title OPERATOR

For KCC Use: Conductor Pipe Required feet: Minimum Surface Pipe Required 20 feet per Alt. X(2) This Authorization Expires 6-17-88 Approved By 12-17-87


EFFECTIVE DATE: 12-22-87

Must be filed with the K.C.C. five (5) days prior to commencing well
 This card void if drilling not started within six (6) months of date received by K.C.C.

Important procedures to follow:

1. Notify District office before setting surface casing.
2. Set surface casing by circulating cement to the top.
3. File completion forms ACO-1 with K.C.C. within 90 days of well completion, following instructions on ACO-1, side 1, and including copies of wireline logs.
4. Notify District office 48 hours prior to old well workover or re-entry.
5. Prior to filing Intent, prepare a proposed plugging plan in case well is D & A, then obtain approval of plan when calling district office prior to setting surface pipe.
6. Submit plugging report (CP-4) to K.C.C. after plugging is completed.
7. Obtain an approved injection docket number before disposing of salt water.
8. Notify K.C.C. within 10 days when injection commences or terminates.
9. If an alternate 2 completion, cement in the production pipe from below any usable water to surface within 120 days of spud date.

**A Regular Section of Land
 1 Mile = 5,280 Ft.**

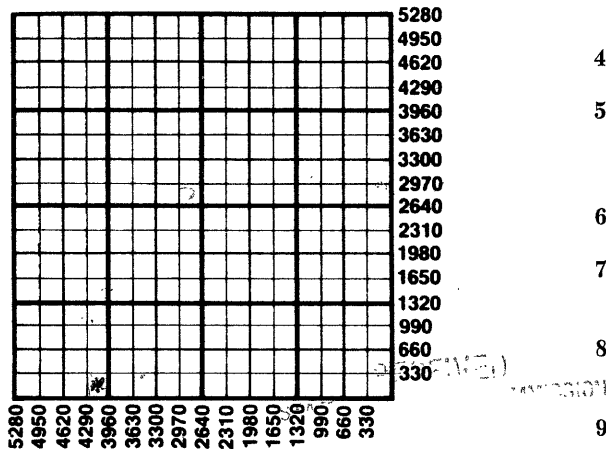

DFC 4 6 1987

CONSERVATION DIVISION
 Wichita, Kansas

12-16-87

State Corporation Commission of Kansas
 Conservation Division
 200 Colorado Derby Building
 Wichita, Kansas 67202
 (316) 263-3238