

CARD MUST BE TYPED

State of Kansas

CARD MUST BE SIGNED

NOTICE OF INTENTION TO DRILL

(see rules on reverse side)

Starting Date 5-8 - 1987
month day year

API Number 15- 207-25,513 -0000

OPERATOR: License # 6553
Name ... Union Corporation
Address ... 9th & Charles
City/State/Zip Humboldt, Ks. ... 66748
Contact Person ... Lyle D. Kee
Phone ... 316-473-3804

SE. SE SW. Sec. 27... Twp. 23 S, Rg. 17... ~~West~~ East
..... 165 Ft. from South Line of Section
..... 2645 Ft. from East Line of Section

(Note: Locate well on Section Plat on reverse side)

CONTRACTOR: License # 6553
Name ... Union Corporation
City/State ... Humboldt, Ks. ... 66748

Nearest lease or unit boundary line ... 165 feet
County ... Woodson

Lease Name ... McClure Well # 1-87
Ground surface elevation ... unknown feet MSL

Well Drilled For: Well Class: Type Equipment:
 Oil SWD Infield Mud Rotary
 Gas Inj Pool Ext. Air Rotary
 OWWO Expl Wildcat Cable

Domestic well within 330 feet: yes no
Municipal well within one mile: yes no

Depth to bottom of fresh water ... 20

Depth to bottom of usable water ... 150

Surface pipe by Alternate: 1 2

If OWWO: old well info as follows:

Surface pipe planned to be set ... 20

Operator
Well Name
Comp Date Old Total Depth

Conductor pipe required

Projected Total Depth ... 1200 feet

Formation ... Mississippi

I certify that well will comply with K.S.A. 55-101, et seq., plus eventually plugging hole to KCC specifications.

Date ... 4-22-87 ... Signature of Operator or Agent ... Carolyn McClure ... Title ... Sec.

For KCC Use:

Conductor Pipe Required feet; Minimum Surface Pipe Required feet per Alt. 20

This Authorization Expires ... 10-22-87 ... Approved By ... 4-22-87


[Handwritten signature]

Must be filed with the K.C.C. five (5) days prior to commencing well
This card void if drilling not started within six (6) months of date received by K.C.C.

Important procedures to follow:

1. Notify District office before setting surface casing.
2. Set surface casing by circulating cement to the top.
3. File completion forms ACO-1 with K.C.C. within 90 days of well completion, following instructions on ACO-1, side 1, and including copies of wireline logs.
4. Notify District office 48 hours prior to old well workover or re-entry.
5. Prior to filing Intent, prepare a proposed plugging plan in case well is D & A, then obtain approval of plan when calling district office prior to setting surface pipe.
6. Submit plugging report (CP-4) to K.C.C. after plugging is completed.
7. Obtain an approved injection docket number before disposing of salt water.
8. Notify K.C.C. within 10 days when injection commences or terminates.
9. If an alternate 2 completion, cement in the production pipe from below any usable water to surface within 120 days of spud date.

**A Regular Section of Land
1 Mile = 5,280 Ft.**

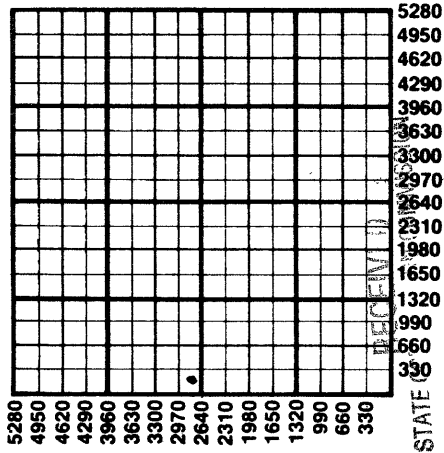

422-87

APR 22 1987

CONSULTATION DIVISION
Wichita, Kansas

State Corporation Commission of Kansas
Conservation Division
200 Colorado Derby Building
Wichita, Kansas 67202
(316) 263-3238