

CARD MUST BE TYPED

State of Kansas
NOTICE OF INTENTION TO DRILL

CARD MUST BE SIGNED

(see rules on reverse side)

Starting Date: July 18 1984
month day year

API Number 15-207-24,95300-00
SW $\frac{1}{2}$ Sec. 29 Twp 23 S, Rge 17. East

OPERATOR: License # 7529
Name M & M Exploration Co.
Address Box 93
City/State/Zip Neosho Falls, Ks. 66758
Contact Person William E. McCullough
Phone 316-963-2105

..... 165..... Ft North from Southeast Corner of Section
3740..... Ft West from Southeast Corner of Section
(Note: Locate well on Section Plat on reverse side)

CONTRACTOR: License # 7661
Name Kelly Down Inc.
City/State Neosho Falls, Ks.

Nearest lease or unit boundary line 165 feet.
County Woodson
Lease Name Dunne Well# 19

Domestic well within 330 feet: yes no
Municipal well within one mile: yes no

Well Drilled For: Well Class: Type Equipment:
 Oil Swd Infield Mud Rotary
 Gas Inj Pool Ext. Air Rotary
 OWWO Expl Wildcat Cable

Depth to Bottom of fresh water 20 feet
Lowest usable water formation Unknown
Depth to Bottom of usable water Unknown 150 feet
Surface pipe by Alternate: 1 2
Surface pipe to be set 40 feet
Conductor pipe if any required feet
Ground surface elevation 970 feet MSL
This Authorization Expires 7-16-85
Approved By RCM/RCC 7-16-84

If OWWO: old well info as follows:

Operator
Well Name
Comp Date Old Total Depth
Projected Total Depth 950 feet
Projected Formation at TD Lower Squirrel
Expected Producing Formations Lower Squirrel

I certify that we will comply with K.S.A. 55-101, et seq., plus eventually plugging hole to K.C.C. specifications.

Date 7-13-84 Signature of Operator or Agent William E. McCullough Title (Partner)

MHC/KOHE 7-16-84

Must be filed with the K.C.C. five (5) days prior to commencing well
This card void if drilling not started within six (6) months of date received by K.C.C.

7-16-84
RECEIVED


STATE CORPORATION COMMISSION

Important procedures to follow :

JUL 16 1984

1. Notify District office before setting surface casing.
2. Set surface casing by circulating cement to the top.
3. File completion forms ACO-1 with K.C.C. within 90 days of well completion, following instructions on ACO-1, side 1, and including copies of wireline logs.
4. Notify District office 48 hours prior to old well workover or re-entry.
5. Prior to plugging, prepare a plugging plan, then obtain agreement from the appropriate district office for an approved plugging plan.
6. Submit plugging report (CP-4) to K.C.C. after plugging is completed.
7. Obtain an approved injection docket number before disposing of salt water.
8. Notify K.C.C. within 10 days when injection commences or terminates.
9. If an alternate 2 completion, cement in the production pipe from below any usable water to surface within 120 days of spud date.

**A Regular Section of Land
1 Mile = 5,280 Ft.**

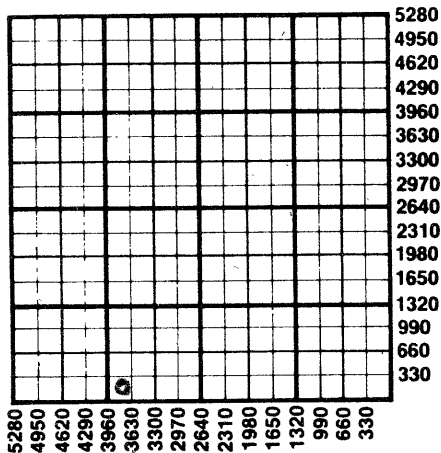

State Corporation Commission of Kansas
Conservation Division
200 Colorado Derby Building
Wichita, Kansas 67202
(316) 263-3238