

CARD MUST BE TYPED

State of Kansas

CARD MUST BE SIGNED

NOTICE OF INTENTION TO DRILL

(see rules on reverse side)

Starting Date 8 15 85
month day year

API Number 15— 207-25,365-00-00

OPERATOR: License #

7667

S. E. 1/4 Sec. 30 Twp. 23 S, Rg. 17 X East

Name Ray Bell O/C

495 Ft. from South Line of Section

Address Rt. 3

1825 Ft. from East Line of Section

City/State/Zip Iola, Kans. 66749

Contact Person Ray Bell

Phone 316 365 2786

(Note: Locate well on Section Plat on reverse side)

CONTRACTOR: License #

6716

Nearest lease or unit boundary line 495 feet

County Woodson

Name Schold Phillip Colson

Lease Name Russell George Well # 20

City/State Chanute, Kans. 66720

Ground surface elevation 900 feet MSL

Well Drilled For:

Well Class:

Type Equipment:

<input checked="" type="checkbox"/> Oil	<input type="checkbox"/> SWD	<input checked="" type="checkbox"/> Infield	<input checked="" type="checkbox"/> Mud Rotary
<input type="checkbox"/> Gas	<input type="checkbox"/> Inj	<input type="checkbox"/> Pool Ext.	<input type="checkbox"/> Air Rotary
<input type="checkbox"/> OWWO	<input type="checkbox"/> Expl	<input type="checkbox"/> Wildcat	<input type="checkbox"/> Cable

Domestic well within 330 feet: _____ yes ☒ noMunicipal well within one mile: _____ yes ☒ noSurface pipe by Alternate: 1 _____ 2 ☒ 3 _____

If OWWO: old well info as follows:

Operator

Well Name

Comp Date Old Total Depth

Depth to bottom of fresh water 20

Depth to bottom of usable water 150

Surface pipe planned to be set 40 cemented

Projected Total Depth 900 feet

Formation Squirrel

I certify that well will comply with K.S.A. 55-101, et seq., plus eventually plugging hole to KCC specifications.

_____ Alternate 3 cementing will be done immediately upon setting production casing.

Date 8.12.85. Signature of Operator or Agent Ray Bell Title owner

For KCC Use:

Conductor Pipe Required feet; Minimum Surface Pipe Required feet per Alt. 1 2 3

This Authorization Expires 2-15-86 Approved By 8-15-85


RCA for KANE

Must be filed with the K.C.C. five (5) days prior to commencing well
This card void if drilling not started within six (6) months of date received by K.C.C.

Important procedures to follow:

1. Notify District office before setting surface casing.
2. Set surface casing by circulating cement to the top.
3. File completion forms ACO-1 with K.C.C. within 90 days of well completion, following instructions on ACO-1, side 1, and including copies of wireline logs.
4. Notify District office 48 hours prior to old well workover or re-entry.
5. Prior to filing Intent, prepare a proposed plugging plan in case well is D & A, then obtain approval of plan when calling district office prior to setting surface pipe.
6. Submit plugging report (CP-4) to K.C.C. after plugging is completed.
7. Obtain an approved injection docket number before disposing of salt water.
8. Notify K.C.C. within 10 days when injection commences or terminates.
9. If an alternate 2 completion, cement in the production pipe from below any usable water to surface within 120 days of spud date.

A Regular Section of Land
1 Mile = 5,280 Ft.

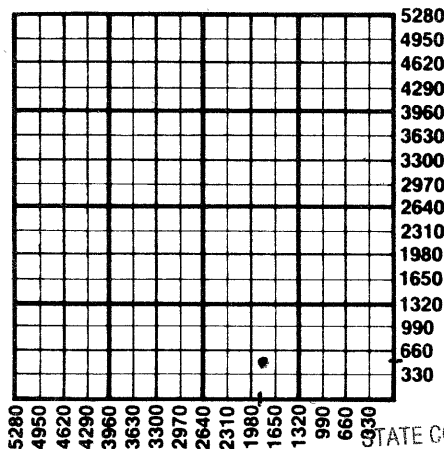

RECEIVED

STATE CORPORATION COMMISSION

AUG 15 1985

CONSERVATION DIVISION
Wichita, Kansas

8-B-85

State Corporation Commission of Kansas
Conservation Division
200 Colorado Derby Building
Wichita, Kansas 67202
(316) 263-3238