

CARD MUST BE TYPED

State of Kansas

CARD MUST BE SIGNED

NOTICE OF INTENTION TO DRILL

(see rules on reverse side)

Starting Date March 3 1987
month day year

API Number 15— 107-25,500-00-00

OPERATOR: License # 6553

^{SW} ~~SE~~ NW. NE.. Sec. 33. Twp. 23. S, Rg. 17... XX East
_____ West

Name Union Corporation

..... 4130 Ft. from South Line of Section

Address ... 9th. & Charles

..... 2165 Ft. from East Line of Section

City/State/Zip ... Humboldt, Ks. 66748

(Note: Locate well on Section Plat on reverse side)

Contact Person... Lyle D. Kee

Nearest lease or unit boundary line ... 170 feet

Phone... 316-473-3804

County..... Woodson

CONTRACTOR: License # 6553

Lease Name... Decker Well #... 1-A

Name Union Corporation

Ground surface elevation ... unknown feet MSL

City/State Humboldt, Ks. 66748

Domestic well within 330 feet: _____ yes XX no

Well Drilled For: Well Class: Type Equipment:

Municipal well within one mile: _____ yes XX no

Oil _____ SWD _____ Infield _____ Mud Rotary

Depth to bottom of fresh water..... 20

_____ Gas _____ Inj _____ Pool Ext. _____ Air Rotary

Depth to bottom of usable water ... 150

_____ OWWO _____ Expl Wildcat _____ Cable

Surface pipe by Alternate: _____ 1 _____ 2 XX

If OWWO: old well info as follows:

Surface pipe planned to be set 20

Operator

Conductor pipe required 0

Well Name

Projected Total Depth 1200 feet

Comp Date Old Total Depth.....

Formation... Mississippi

I certify that well will comply with K.S.A. 55-101, et seq., plus eventually plugging hole to KCC specifications.

Date 2-17-87 Signature of Operator or Agent Caryl M. Clauer Title... Secretary

For KCC Use:

Conductor Pipe Required feet; Minimum Surface Pipe Required 20 feet per Alt. 4 ²


This Authorization Expires 8-18-87 Approved By 2-19-87

Must be filed with the K.C.C. five (5) days prior to commencing well
 This card void if drilling not started within six (6) months of date received by K.C.C.

Important procedures to follow:

1. Notify District office before setting surface casing.
2. Set surface casing by circulating cement to the top.
3. File completion forms ACO-1 with K.C.C. within 90 days of well completion, following instructions on ACO-1, side 1, and including copies of wireline logs.
4. Notify District office 48 hours prior to old well workover or re-entry.
5. Prior to filing Intent, prepare a proposed plugging plan in case well is D & A, then obtain approval of plan when calling district office prior to setting surface pipe.
6. Submit plugging report (CP-4) to K.C.C. after plugging is completed.
7. Obtain an approved injection docket number before disposing of salt water.
 Notify K.C.C. within 10 days when injection commences or terminates.
9. If an alternate 2 completion, cement in the production pipe from below any usable water to surface within 120 days of spud date.

**A Regular Section of Land
 1 Mile = 5,280 Ft.**

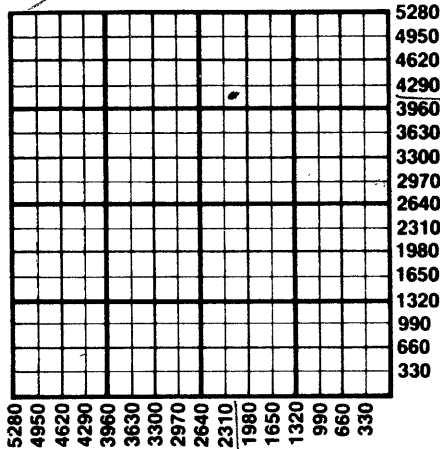

CONSERVATION DIVISION
 Wichita, Kansas

FEB 18 1987

STATE CORPORATION COMMISSION

2-18-87

State Corporation Commission of Kansas
 Conservation Division
 200 Colorado Derby Building
 Wichita, Kansas 67202
 (316) 263-3238