

CARD MUST BE TYPED

State of Kansas

CARD MUST BE SIGNED

NOTICE OF INTENTION TO DRILL

(see rules on reverse side)

Starting Date Feb 6 1987
month day year

API Number 15— 207-25499-0000

OPERATOR: License # 6553

SE .NE .NE Sec. 33. Twp. 23. S, Rg. 17... ☒ East

4145 Ft. from South Line of Section

185 Ft. from East Line of Section

(Note: Locate well on Section Plat on reverse side)

Nearest lease or unit boundary line ... 185 feet

County ... Woodson

Lease Name ... Decker Well # ... 2

Ground surface elevation ... unknown feet MSL

Domestic well within 330 feet: _____ yes ☒ noMunicipal well within one mile: _____ yes ☒ no

Depth to bottom of fresh water 20

Depth to bottom of usable water ... 150

Surface pipe by Alternate: _____ 1 _____ 2 ☒

Surface pipe planned to be set 20

Conductor pipe required 0

Projected Total Depth 1200

Formation ... Mississippi

Name Union Corp.

Address P.O. Box 37

City/State/Zip ... Humboldt, Kansas ... 66748

Contact Person ... Lyle D. Kee

Phone ... 316-473-3804

CONTRACTOR: License # 6553

Name Union Corp.

City/State ... Humboldt, Kansas ... 66748

Well Drilled For: Well Class: Type Equipment:

☒ Oil _____ SWD _____ Infield ☒ Mud Rotary

_____ Gas _____ Inj _____ Pool Ext. _____ Air Rotary

_____ OWWO _____ Expl ☒ Wildcat _____ Cable

If OWWO: old well info as follows:

Operator

Well Name

Comp Date Old Total Depth

I certify that well will comply with K.S.A. 55-101, et seq., plus eventually plugging hole to KCC specifications.

Date ... 1/30/87 ... Signature of Operator or Agent ... Title ... Secretary

For KCC Use:

Conductor Pipe Required feet; Minimum Surface Pipe Required feet per Alt. # 2


This Authorization Expires ... 8-2-87 ... Approved By ... 2-2-87 ...

Must be filed with the K.C.C. five (5) days prior to commencing well
This card void if drilling not started within six (6) months of date received by K.C.C.

Important procedures to follow:

1. Notify District office before setting surface casing.
2. Set surface casing by circulating cement to the top.
3. File completion forms ACO-1 with K.C.C. within 90 days of well completion, following instructions on ACO-1, side 1, and including copies of wireline logs.
4. Notify District office 48 hours prior to old well workover or re-entry.
5. Prior to filing Intent, prepare a proposed plugging plan in case well is D & A, then obtain approval of plan when calling district office prior to setting surface pipe.
6. Submit plugging report (CP-4) to K.C.C. after plugging is completed.
7. Obtain an approved injection docket number before disposing of salt water.
8. Notify K.C.C. within 10 days when injection commences or terminates.
9. If an alternate 2 completion, cement in the production pipe from below any usable water to surface within 120 days of spud date.

A Regular Section of Land 1 Mile = 5,280 Ft.

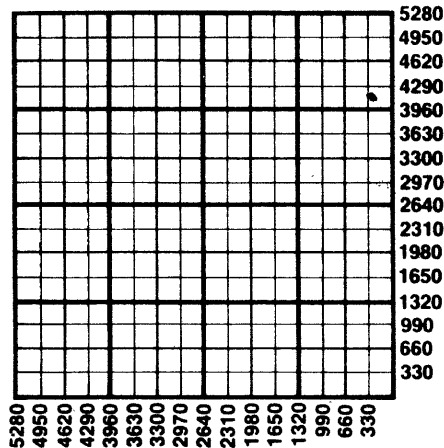

STATE CORPORATION COMMISSION

FEB 2 1967

CONSERVATION DIVISION
Wichita, Kansas

State Corporation Commission of Kansas
Conservation Division
200 Colorado Derby Building
Wichita, Kansas 67202
(316) 263-3238