

TYPE OR PRINT


NOTICE OF INTENTION TO DRILL

C-1

15-207-19989-0000
TO BE FILED WITH THE STATE CORPORATION COMMISSION PRIOR TO COMMENCEMENT OF WELL

1. Operator W. H. Bobbitt Address 3130 Beacon Colorado Springs
2. Lease name Safelite Well No. 1 County Woodson
3. Well Location NE/4 Sec. 30 Township 23 Range 17E
4. Well to be drilled 150 ft. from nearest lease line.
5. Drilling Contractor Bell Bobbs Address Neoches Falls
6. Type of equipment: Rotary ☒ Cable Tool ☐ Approx. date operation to begin immediately
7. Well to be drilled for Oil ☒ Gas ☐ Disposal ☐ Input ☐ Estimated Total Depth of Well 730 ft.
8. Depth of deepest fresh water well within one mile of location none ft. If none exists, write NONE
9. Ground elevation at location is approx. 5000 ft. higher or _____ ft. lower than ground elevation at water well.
10. Depth of the deepest municipal water well within three miles of location 30 ft. If none exists, write NONE
11. Operator states that he will set surface pipe at least 25 ft. below all Tertiary or unconsolidated deposits and, taking into consideration differences in ground elevations, that the minimum depth necessary, to the best of his knowledge and belief, to protect all fresh water zones is 60 ft. and operator agrees to set surface pipe at this location to a depth of not less than _____ ft. Alternate 1 ☐ Alternate 2 ☒.

REMARKS

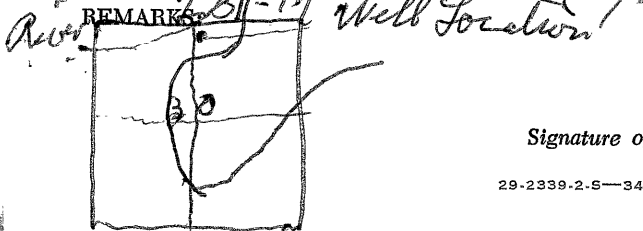

Signature of Operator

W. H. Bobbitt

Place
4¢
Stamp
Here

State Corporation Commission of Kansas
Conservation Division
500 Insurance Building
212 North Market
Wichita 2, Kansas

RECEIVED
STATE CORPORATION COMMISSION

JUL 16 1964

CONSERVATION DIVISION
Wichita, Kansas

7-16-64

(IF PREFERRED, MAIL IN ENVELOPE)