

CARD MUST BE TYPED

State of Kansas
NOTICE OF INTENTION TO DRILL
(see rules on reverse side)

CARD MUST BE SIGNED

Starting Date: 5 10 85
month day year 2'90

API Number 15- 001-27,315-00'00

OPERATOR: License # 7208
Name Loraine Cleaver
Address Box 54
City/State/Zip Piqua, KS 66761
Contact Person Loraine Cleaver
Phone (316) 468-2510

..... NE. NE. SE Sec .35. Twp .23 S, Rge .17. East
..... 247.5.. Ft North from Southeast Corner of Section
..... 165.... Ft West from Southeast Corner of Section
(Note: Locate well on Section Plat on reverse side)

CONTRACTOR: License # 5687
Name Sun Drilling
City/State Box 54, Piqua, KS 66761

Nearest lease or unit boundary line 165 feet.
County Allen
Lease Name .. Loraine Cleaver. Well# ... 1
Domestic well within 330 feet : yes No
Municipal well within one mile : yes No

Well Drilled For: Well Class: Type Equipment:
 Oil Swd Infield Mud Rotary
 Gas Inj Pool Ext. Air Rotary
 OWWO Expl Wildcat Cable

Depth to Bottom of fresh water ~~none~~ 30 feet
Lowest usable water formation
Depth to Bottom of usable water 150 feet
Surface pipe by Alternate : 1 2
Surface pipe to be set 20 feet
Conductor pipe if any required feet
Ground surface elevation feet MSL
This Authorization Expires 11-9-85
Approved By 5-9-85 [Signature]

If OWWO: old well info as follows:

Operator
Well Name
Comp Date Old Total Depth
Projected Total Depth 1200 feet
Projected Formation at TD
Expected Producing Formations


I certify that we will comply with K.S.A. 55-101, et seq., plus eventually plugging hole to K.C.C. specifications.

Date .. 5/9/85 Signature of Operator or Agent *Laquel Robles* Title AS. AGENT.....
Form C-1 4/84

Must be filed with the K.C.C. five (5) days prior to commencing well
 This card void if drilling not started within six (6) months of date received by K.C.C.

Important procedures to follow :

**A Regular Section of Land
 1 Mile = 5,280 Ft.**

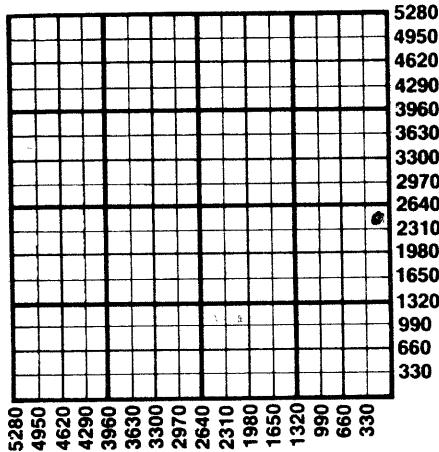

1. Notify District office before setting surface casing.
 2. Set surface casing by circulating cement to the top.
 3. File completion forms ACO-1 with K.C.C. within 90 days of well completion, following instructions on ACO-1, side 1, and including copies of wireline logs.
 4. Notify District office 48 hours prior to old well workover or re-entry.
 5. Prior to plugging, prepare a plugging plan, then obtain agreement from the appropriate district office for an approved plugging plan.
 6. Submit plugging report (CP-4) to K.C.C. after plugging is completed.
 7. Obtain an approved injection docket number before disposing of salt water.
 8. Notify K.C.C. within 10 days when injection commences or terminates.

RECEIVED
 STATE CORPORATION COMMISSION

MAY 9 1985

CONSERVATION DIVISION
 Wichita, Kansas

5-9-85

State Corporation Commission of Kansas
 Conservation Division
 200 Colorado Derby Building
 Wichita, Kansas 67202
 (316) 263-3238