

CARD MUST BE TYPED

# State of Kansas NOTICE OF INTENTION TO DRILL

(see rules on reverse side)

CARD MUST BE SIGNED

Starting Date: ..... 11 14 85 .....  
month day year

API Number 15- 003-22,701-00-00  
~~SE~~ ~~NE~~ SW NW  $\frac{1}{4}$  Sec 35. Twp 21 S, Rge 19  East  West  
(location)

OPERATOR: License # 5499  
Name BRECHEISEN OIL COMPANY  
Address BOX 40  
City/State/Zip GARNETT, KANSAS 66032  
Contact Person A W Brecheisen  
Phone 913-448-6952

3165 ..... Ft North from Southeast Corner of Section  
4015 ..... Ft West from Southeast Corner of Section  
(Note: Locate well on Section Plat on reverse side)

CONTRACTOR: License # 8102  
Name Hastert Oil Company  
City/State Garnett, Kansas 66032

Nearest lease or unit boundary line 525 ..... feet.  
County Anderson  
Lease Name Summers Well# 1 P 85

Well Drilled For: Well Class: Type Equipment:  
 Oil  Swd  Infield  Mud Rotary  
 Gas  Inj  Pool Ext.  Air Rotary  
 OWWO  Expl  Wildcat  Cable

Domestic well within 330 feet:  yes  no  
Municipal well within one mile:  yes  no

If OWWO: old well info as follows:  
Operator .....  
Well Name .....  
Comp Date ..... Old Total Depth .....  
Projected Total Depth 850 ..... feet  
Projected Formation at TD Squirrell .....  
Expected Producing Formations .....

Depth to Bottom of fresh water none EST 20' ..... feet  
Lowest usable water formation none .....  
Depth to Bottom of usable water 125 ..... feet  
Surface pipe by Alternate: 1  2  .....  
Surface pipe to be set 20 ..... feet  
Conductor pipe if any required none ..... feet  
Ground surface elevation ..... feet MSL  
This Authorization Expires 5-12-86  
Approved By 11-12-85 *Re*

I certify that we will comply with K.S.A. 55-101, et seq., plus eventually plugging hole to K.C.C. specifications.


Date 11-7-85 Signature of Operator or Agent *David Ulles*

Title Office Manager

Must be filed with the K.C.C. five (5) days prior to commencing well  
This card void if drilling not started within six (6) months of date received by K.C.C.

**Important procedures to follow :**

**A Regular Section of Land  
1 Mile = 5,280 Ft.**

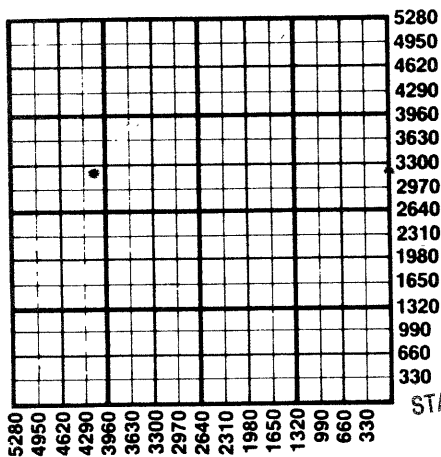

1. Notify District office before setting surface casing.
2. Set surface casing by circulating cement to the top.
3. File completion forms ACO-1 with K.C.C. within 90 days of well completion, following instructions on ACO-1, side 1, and including copies of wireline logs.
4. Notify District office 48 hours prior to old well workover or re-entry.
5. Prior to plugging, prepare a plugging plan, then obtain agreement from the appropriate district office for an approved plugging plan.
6. Submit plugging report (CP-4) to K.C.C. after plugging is completed.
7. Obtain an approved injection docket number before disposing of salt water.
8. Notify K.C.C. within 10 days when injection commences or terminates.
9. If an alternate completion, cement in the production pipe from below any usable water to surface within 120 days of spud date.

RECEIVED  
STATE CORPORATION COMMISSION

NOV 11-12-85  
CONSERVATION DIVISION  
Wichita, Kansas

State Corporation Commission of Kansas  
Conservation Division  
200 Colorado Derby Building  
Wichita, Kansas 67202  
(316) 263-3238