

CARD MUST BE TYPED

State of Kansas

CARD MUST BE SIGNED

## NOTICE OF INTENTION TO DRILL

(see rules on reverse side)

Expected Spud Date.....5 month 24 day 88 yearAPI Number 15— 121-26,907-00-00OPERATOR: License # 6142SE. NW SE Sec. 15 Twp. 19 S, Rg. 22 East  
Name ..... Town Oil Co. ....  
Address ..... Rt. 4 .....  
City/State/Zip ..... Paola, KS.. 66071 .....  
Contact Person ..... Lester Town .....  
Phone ..... 913. 294-2125 .....  
Ft. from South Line of Section 1790  
Ft. from East Line of Section 1500

(Note: Locate well on Section Plat on reverse side)

Nearest lease or unit boundary line ..... 1500 feet  
County ..... MiamiCONTRACTOR: License # COMPANY TOOLSLease Name ..... Chisam ..... Well # ..... 6

Ground surface elevation ..... feet MSL

Domestic well within 330 feet: ..... yes X noMunicipal well within one mile: ..... yes X no

Depth to bottom of fresh water.....

Depth to bottom of usable water ..... 200Surface pipe by Alternate: ..... 1 2 XSurface pipe planned to be set ..... 20

Conductor pipe required ..... none

Projected Total Depth ..... 500 feet

Formation ..... Bartlesville

If OWWO: old well info as follows:

Operator .....

Well Name .....

Comp Date ..... Old Total Depth.....

I certify that well will comply with K.S.A. 55-101, et seq., plus eventually plugging hole to KCC specifications.

Date ..... 5-16-88 ..... Signature of Operator or Agent Donna Kunkel ..... Title Partner

For KCC Use:


Conductor Pipe Required ..... feet; Minimum Surface Pipe Required ..... 20 feet per Alt. X 2This Authorization Expires 11-19-88 ..... Approved By R.H. 5-19-88EFFECTIVE DATE: 5-24-88

Must be filed with the K.C.C. five (5) days prior to commencing well  
This card void if drilling not started within six (6) months of date received by K.C.C.

**Important procedures to follow:**

1. Notify District office before setting surface casing.
2. Set surface casing by circulating cement to the top.
3. File completion forms ACO-1 with K.C.C. within 120 days of well spud date, following instructions on ACO-1, side 1, and including copies of wireline logs.
4. Notify District office 48 hours prior to old well workover or re-entry.
5. Prior to filing Intent, prepare a proposed plugging plan in case well is D & A, then obtain approval of plan when calling district office prior to setting surface pipe.
6. Submit plugging report (CP-4) to K.C.C. after plugging is completed.
7. Obtain an approved injection docket number before disposing of salt water.
8. Notify K.C.C. within 10 days when injection commences or terminates.
9. For an alternate 2 completion, cement in the production pipe from below any usable water to surface within 120 days of spud date.

**A Regular Section of Land**  
**1 Mile = 5,280 Ft.**

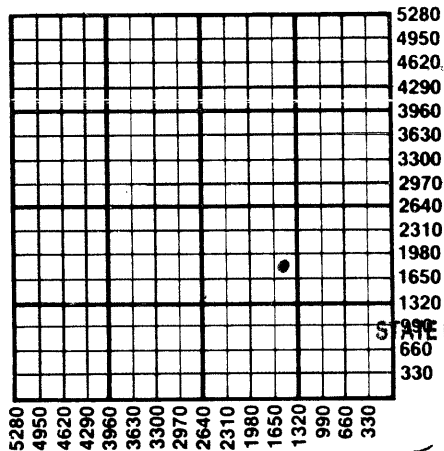

**RECEIVED**  
**STATE CORPORATION COMMISSION**

**MAY 19 1988**

**CONSERVATION DIVISION**  
**Wichita, Kansas**

State Corporation Commission of Kansas  
Conservation Division  
200 Colorado Derby Building  
Wichita, Kansas 67202-1212  
(316) 263-3238