

CARD MUST BE TYPED

State of Kansas
NOTICE OF INTENTION TO DRILL
(see rules on reverse side)

CARD MUST BE SIGNED

Starting Date: 10 15 1984
month day year *5/15*

API Number 15- *207-25090-00-00*

OPERATOR: License # 5935
Name Mark L. Haas Oil Co.
Address Box 288
City/State/Zip Yates Center, Ks. 66783
Contact Person Mark Haas
Phone ... 316. 625. 2171

NE/4 Sec 3 Twp 24. S, Rge 15 East
(location) West
4685 Ft North from Southeast Corner of Section
2575 Ft West from Southeast Corner of Section
(Note: Locate well on Section Plat on reverse side)

CONTRACTOR: License # 7721
Name Coconut Drilling Co.
City/State .. Box 288 Yates Center KS. 66783

Nearest lease or unit boundary line 165 feet.
County Woodson
Lease Name Switzer Well# 1-H

Well Drilled For: Well Class: Type Equipment:
 Oil Swd Infield Mud Rotary
 Gas Inj Pool Ext. Air Rotary
 OWWO Expl Wildcat Cable

Domestic well within 330 feet : yes no
Municipal well within one mile : yes no

If OWWO: old well info as follows:

Operator
Well Name
Comp Date Old Total Depth
Projected Total Depth 1500 feet
Projected Formation at TD Mississippian
Expected Producing Formations

Depth to Bottom of fresh water ... 20 feet
Lowest usable water formation
Depth to Bottom of usable water 150 feet
Surface pipe by Alternate : 1 2
Surface pipe to be set 40 feet
Conductor pipe if any required feet
Ground surface elevation feet MSL
This Authorization Expires *4-15-85*
Approved By *10-15-84* *[Signature]*

I certify that we will comply with K.S.A. 55-101, et seq., plus eventually plugging hole to K.C.C. specifications.


Date 10/15/84 Signature of Operator or Agent *[Signature]* Title as agent

Must be filed with the K.C.C. five (5) days prior to commencing well
This card void if drilling not started within six (6) months of date received by K.C.C.

OCT 15 1984

10-1584

STATE CORPORATION COMMISSION
A Regular Section of Land
1 Mile = 5,280 Ft.

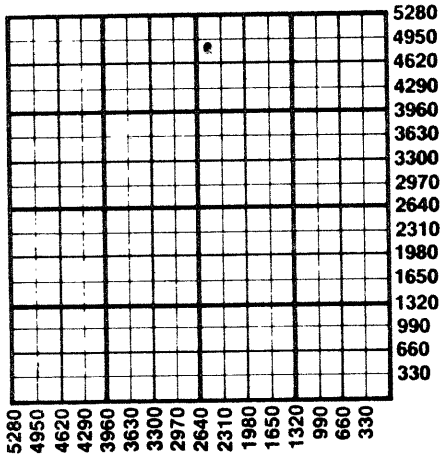

Important procedures to follow :

1. Notify District office before setting surface casing.
2. Set surface casing by circulating cement to the top.
3. File completion forms ACO-1 with K.C.C. within 90 days of well completion, following instructions on ACO-1, side 1, and including copies of wireline logs.
4. Notify District office 48 hours prior to old well workover or re-entry.
5. Prior to plugging, prepare a plugging plan, then obtain agreement from the appropriate district office for an approved plugging plan.
6. Submit plugging report (CP-4) to K.C.C. after plugging is completed.
7. Obtain an approved injection docket number before disposing of salt water.
8. Notify K.C.C. within 10 days when injection commences or terminates.
9. If an alternate 2 completion, cement in the production pipe from below any usable water to surface within 120 days of spud date.

State Corporation Commission of Kansas
Conservation Division
200 Colorado Derby Building
Wichita, Kansas 67202
(316) 263-3238