

CARD MUST BE TYPED

State of Kansas

CARD MUST BE SIGNED

NOTICE OF INTENTION TO DRILL

(see rules on reverse side)

Starting Date October 15, 1985 month day year

API Number 15- 207-25406-0000

OPERATOR: License # 5983 Name Victor J. Leis Drlg. Co. Address POB 223 City/State/Zip Yates Center, KS 66783 Contact Person Victor J. Leis Phone 316-625-2106

CL SE 1/4 NW NW Sec. 3 Twp. 24 S, Rg 15 East 4620 Ft. from South Line of Section 4180 Ft. from East Line of Section

(Note: Locate well on Section Plat on reverse side)

CONTRACTOR: License # 5367 Name Double L Drlg Co City/State Yates Center, KS

Nearest lease or unit boundary line 660 feet County Woodson Lease Name Switzer Well # 15 Ground surface elevation N/A feet MSL

Well Drilled For: Oil SWD Infield Mud Rotary Gas Inj Pool Ext Air Rotary OWWO Expl Wildcat Cable

Domestic well within 330 feet: yes no Municipal well within one mile: yes no Surface pipe by Alternate: 1 2 X

If OWWO: old well info as follows:

Operator Well Name Comp Date Old Total Depth

Depth to bottom of fresh water 15 Depth to bottom of usable water 150 Surface pipe planned to be set 40 Projected Total Depth 1550 feet Formation Mississippi

I certify that well will comply with K.S.A. 55-101, et seq., plus eventually plugging hole to KCC specifications.

cementing will be done immediately upon setting production casing.

Date 10/15/85 Signature of Operator or Agent Title Owner

For KCC Use:

Conductor Pipe Required feet; Minimum Surface Pipe Required feet per Alt. 1 2


This Authorization Expires 4-16-86 Approved By RCA 10-16-85

Must be filed with the K.C.C. five (5) days prior to commencing well
 This card void if drilling not started within six (6) months of date received by K.C.C.

Important procedures to follow:

1. Notify District office before setting surface casing.
2. Set surface casing by circulating cement to the top.
3. File completion forms ACO-1 with K.C.C. within 90 days of well completion, following instructions on ACO-1, side 1, and including copies of wireline logs.
4. Notify District office 48 hours prior to old well workover or re-entry.
5. Prior to filing Intent, prepare a proposed plugging plan in case well is D & A, then obtain approval of plan when calling district office prior to setting surface pipe.
6. Submit plugging report (CP-4) to K.C.C. after plugging is completed.
7. Obtain an approved injection docket number before disposing of salt water.
8. Notify K.C.C. within 10 days when injection commences or terminates.
9. If an alternate 2 completion, cement in the production pipe from bottom any usable water to surface within 120 days of spud date.

A Regular Section of Land
1 Mile = 5,280 Ft.

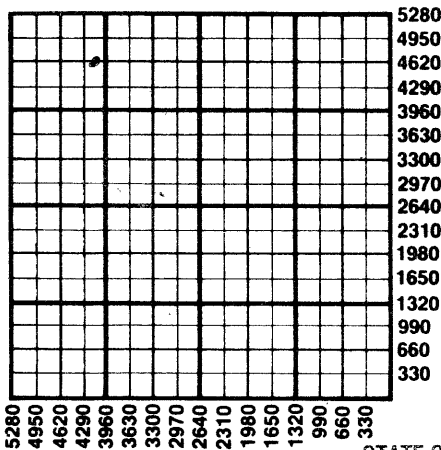

RECEIVED
 STATE CORPORATION COMMISSION

10-16-85

OCT 16 1985

CONSERVATION DIVISION
 Wichita, Kansas

State Corporation Commission of Kansas
 Conservation Division
 200 Colorado Derby Building
 Wichita, Kansas 67202
 (316) 263-3238