

CARD MUST BE TYPED

State of Kansas

CARD MUST BE SIGNED

NOTICE OF INTENTION TO DRILL

(see rules on reverse side)

Starting Date Feb 11 1986
month day year

API Number 15- 207-25,459-00-00

OPERATOR: License # 9967
Name Sujen Enterprises, Inc.
Address 432 Bergen Blvd.
City/State/Zip Richfield, N.J. 07657
Contact Person Ronald Fleming
Phone 316-431-1271

app. SE SE SW Sec. 12 Twp. 24 S, Rg. 15 East
495 Ft. from South Line of Section
2805 Ft. from East Line of Section

(Note: Locate well on Section Plat on reverse side)

CONTRACTOR: License # 5378
Name Ronald Fleming
City/State 1209 Plummer, Chanute, KS 66720

Nearest lease or unit boundary line 495 feet
County Woodson
Lease Name Weston Farm Well # 3-E

Well Drilled For: Well Class: Type Equipment:
 Oil SWD Infield Mud Rotary
 Gas Inj Pool Ext. Air Rotary
 OWWO Expl Wildcat Cable

Ground surface elevation feet MSL
Domestic well within 330 feet: yes no
Municipal well within one mile: yes no
Depth to bottom of fresh water 20
Depth to bottom of usable water 200-150

If OWWO: old well info as follows:

Surface pipe by Alternate: 1 ~~2XX~~
Surface pipe planned to be set 40
Conductor pipe required
Projected Total Depth 1000 feet
Formation

Operator
Well Name
Comp Date Old Total Depth

I certify that well will comply with K.S.A. 55-101, et seq., plus eventually plugging hole to KCC specifications.

Date 2/7/86 Signature of Operator or Agent Sheri Cooper Title as agent

For KCC Use:


Conductor Pipe Required feet; Minimum Surface Pipe Required 40 feet per Alt. 2
This Authorization Expires 8-7-86 Approved By 2-7-86

Must be filed with the K.C.C. five (5) days prior to commencing well
 This card void if drilling not started within six (6) months of date received by K.C.C.

Important procedures to follow:

1. Notify District office before setting surface casing.
2. Set surface casing by circulating cement to the top.
3. File completion forms ACO-1 with K.C.C. within 90 days of well completion, following instructions on ACO-1, side 1, and including copies of wireline logs.
4. Notify District office 48 hours prior to old well workover or re-entry.
5. Prior to filing Intent, prepare a proposed plugging plan in case well is D & A, then obtain approval of plan when calling district office prior to setting surface pipe.
6. Submit plugging report (CP-4) to K.C.C. after plugging is completed.
7. Obtain an approved injection docket number before disposing of salt water.
8. Notify K.C.C. within 10 days when injection commences or terminates.
9. If an alternate 2 completion, cement in the production pipe from below any usable water to surface within 120 days of spud date.

**A Regular Section of Land
 1 Mile = 5,280 Ft.**

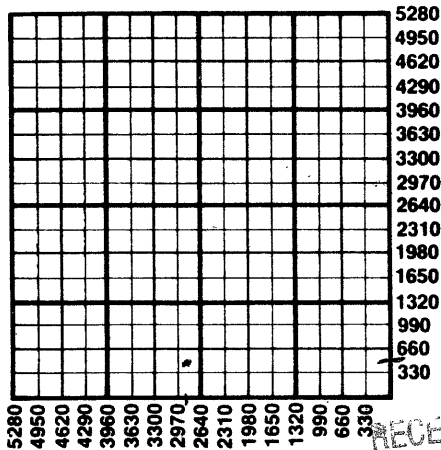

RECEIVED
 STATE CORPORATION COMMISSION

FEB - 7 1986
 2-7-86
 CONSERVATION DIVISION
 Wichita, Kansas

State Corporation Commission of Kansas
 Conservation Division
 200 Colorado Derby Building
 Wichita, Kansas 67202
 (316) 263-3238