

CARD MUST BE TYPED

State of Kansas

CARD MUST BE SIGNED

NOTICE OF INTENTION TO DRILL

(see rules on reverse side)

Starting Date 5 20 88
month day year

API Number 15-003-22.905-00-00 ✓ JA
10
 East

OPERATOR: License # 03390
Name KenLeCo Oil & Gas Corp.
Address Route 1
City/State/Zip Garnett, Ks 66032
Contact Person H. H. Lemon
Phone 913/898-6218

NW NW SW Sec. 13. Twp. 21. S, Rg. 20. West
2560 Ft. from South Line of Section
5115 Ft. from East Line of Section

(Note: Locate well on Section Plat on reverse side)

CONTRACTOR: License #
Name Unknown
City/State

Nearest lease or unit boundary line 165 feet
County Anderson
Lease Name VanWinkle Well # 88-8

Well Drilled For: Well Class: Type Equipment:
 Oil SWD Infield Mud Rotary
 Gas Inj Pool Ext. Air Rotary
 OWWO Expl Wildcat Cable

Ground surface elevation NA feet MSL
Domestic well within 330 feet: _____ yes no
Municipal well within one mile: _____ yes no

If OWWO: old well info as follows:
Operator
Well Name
Comp Date Old Total Depth

Depth to bottom of fresh water NA
Depth to bottom of usable water 100/25
Surface pipe by Alternate: 1 2 _____
Surface pipe planned to be set 20'
Conductor pipe required none
Projected Total Depth 800' feet
Formation Squirell

I certify that well will comply with K.S.A. 55-101, et seq., plus eventually plugging hole to KCC specifications.

Date 5/13/88 Signature of Operator or Agent *H.H. Lemon* Title VP

For KCC Use:
Conductor Pipe Required feet; Minimum Surface Pipe Required 20 feet per Alt. 2
This Authorization Expires 11-16-88 Approved By *2/4 5/16/88*


EFFECTIVE DATE: 5-21-88

Must be filed with the K.C.C. five (5) days prior to commencing well
 This card void if drilling not started within six (6) months of date received by K.C.C.

Important procedures to follow:

1. Notify District office before setting surface casing.
2. Set surface casing by circulating cement to the top.
3. File completion forms ACO-1 with K.C.C. within 90 days of well completion, following instructions on ACO-1, side 1, and including copies of wireline logs.
4. Notify District office 48 hours prior to old well workover or re-entry.
5. Prior to filing Intent, prepare a proposed plugging plan in case well is D & A, then obtain approval of plan when calling district office prior to setting surface pipe.
6. Submit plugging report (CP-4) to K.C.C. after plugging is completed.
7. Obtain an approved injection docket number before disposing of salt water.

**A Regular Section of Land
 1 Mile = 5,280 Ft.**

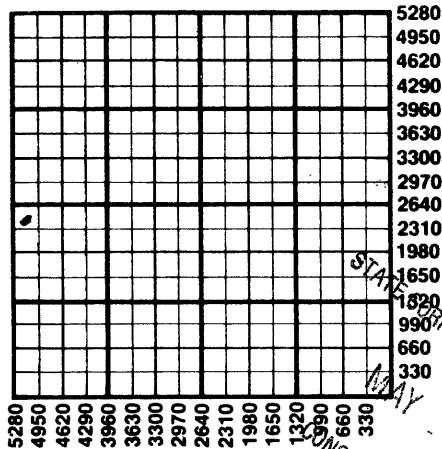

RECEIVED
 STATE CORPORATION COMMISSION
 MAY 10 1988
 5-16-88
 CONSERVATION DIVISION
 WICHITA, KANSAS

Notify K.C.C. within 10 days when injection commences or termi-

If alternate 2 completion, cement in the production pipe from below as usable water to surface within 120 days of spud date.

State Corporation Commission of Kansas
 Conservation Division
 200 Colorado Derby Building
 Wichita, Kansas 67202
 (316) 263-3238