

CARD MUST BE TYPED

State of Kansas  
**NOTICE OF INTENTION TO DRILL**  
(see rules on reverse side)

CARD MUST BE SIGNED

March 15, 1985

Starting Date: ..... month day year

API Number 15- 003-22,584-00-00

**OPERATOR:** License # 6029  
Name Ladd Petroleum Corporation  
Address P. O. Box 2848  
City/State/Zip Tulsa, Oklahoma 74101  
Contact Person J. M. Newman  
Phone (918) 587-6531

SE/4 SE/4 NE/4 SW/4 Sec 7 Twp 21 S, Rge 20  East  West  
(location)  
Actual ( 1485 Ft North from Southeast Corner of Section  
Location ( 2840 Ft West from Southeast Corner of Section  
(Note: Locate well on Section Plat on reverse side)

**CONTRACTOR:** License # .....  
Name Unknown  
City/State .....

Nearest lease or unit boundary line 1485 feet.  
County Anderson  
Lease Name S. P. Johnson Well# K-17  
Domestic well within 330 feet:  yes  no  
Municipal well within one mile:  yes  no

**Well Drilled For:** **Well Class:** **Type Equipment:**  
 Oil  Swd  Infield  Mud Rotary  
 Gas  Inj  Pool Ext.  Air Rotary  
 OWWO  Expl  Wildcat  Cable

Depth to Bottom of fresh water 100 feet  
Lowest usable water formation Unconsolidated  
Depth to Bottom of usable water 125 feet  
Surface pipe by Alternate: 1  2   
Surface pipe to be set 20 feet  
Conductor pipe if any required ..... feet  
Ground surface elevation  $\pm 1100$  feet MSL  
This Authorization Expires 8-28-85  
Approved By 2-28-85 *J.C.*

If OWWO: old well info as follows:  
Operator .....  
Well Name .....  
Comp Date ..... Old Total Depth .....  
Projected Total Depth 890 feet  
Projected Formation at TD Shale  
Expected Producing Formations Squirrel Sand

I certify that we will comply with K.S.A. 55-101, et seq., plus eventually plugging hole to K.C.C. specifications.


Date 2/26/85 Signature of Operator or Agent *J. M. Newman* Title Production Engineer

*MHC/UDHE 2-28-85*

Must be filed with the K.C.C. five (5) days prior to commencing well  
This card void if drilling not started within six (6) months of date received by K.C.C.

**Important procedures to follow :**

**A Regular Section of Land  
1 Mile = 5,280 Ft.**

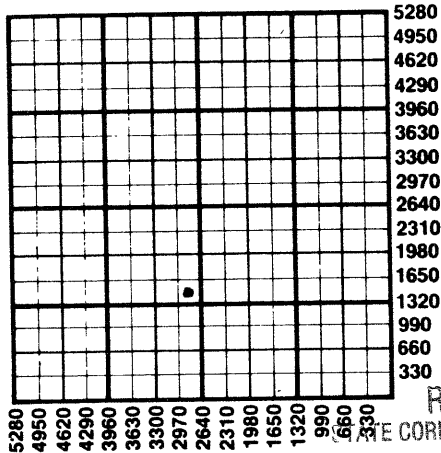

1. Notify District office before setting surface casing.
2. Set surface casing by circulating cement to the top.
3. File completion forms ACO-1 with K.C.C. within 90 days of well completion, following instructions on ACO-1, side 1, and including copies of wireline logs.
4. Notify District office 48 hours prior to old well workover or re-entry.
5. Prior to plugging, prepare a plugging plan, then obtain agreement from the appropriate district office for an approved plugging plan.
6. Submit plugging report (CP-4) to K.C.C. after plugging is completed.
7. Obtain an approved injection docket number before disposing of salt water.
8. Notify K.C.C. within 10 days when injection commences or terminates.
9. If an alternate 2 completion, cement in the production pipe from below any usable water to surface within 120 days of spud date.

RECEIVED

STATE CORPORATION COMMISSION

State Corporation Commission of Kansas  
Conservation Division  
200 Colorado Derby Building  
Wichita, Kansas 67202  
(316) 263-3238

FEB 28 1985  
02-28-85  
CONSERVATION DIVISION  
Wichita, Kansas