

CARD MUST BE TYPED

State of Kansas

CARD MUST BE SIGNED ✓

NOTICE OF INTENTION TO DRILL

(see rules on reverse side)

Expected Spud Date..... **MARCH 9, 1987**
month day year *2:52*

API Number 15— **003-22,777-00-00**

OPERATOR: License #..... **#6004**
Name..... **CALDWELL ENTERPRISES, INC.**
Address..... **P. O. BOX 42**
City/State/Zip..... **GARNETT, KANSAS 66032**
Contact Person..... **GLEN CALDWELL**
Phone..... **913-448-3578**

1/2 SE SW Sec. **8** Twp. **21** S. Rg. **20** East
_____ Ft. from South Line of Section
1150
_____ Ft. from East Line of Section
3300

(Note: Locate well on Section Plat on reverse side)

CONTRACTOR: License #..... **5820**
Name..... **KENT DRILLING COMPANY**
City/State..... **GARNETT, KANSAS 66032 HAYS, KS 67601**

Nearest lease or unit boundary line..... **660** feet
County..... **ANDERSON**
Lease Name..... **WILSON** Well #..... **5-I**

Well Drilled For: Well Class: Type Equipment:
 Oil _____ Storage _____ Infield _____ Mud Rotary
_____ Gas _____ Inj _____ Pool Ext. _____ Air Rotary
_____ OWWO _____ Expl _____ Wildcat _____ Cable

Ground surface elevation..... feet MSL
Domestic well within 330 feet: _____ yes No
Municipal well within one mile: _____ yes No
Depth to bottom of fresh water..... **20** feet
Depth to bottom of usable water..... **125** feet
Surface pipe by Alternate: _____ 1 _____ 2
Surface pipe planned to be set..... **20** feet
Conductor pipe required _____
Projected Total Depth..... **870** feet
Formation..... **SQUIRREL**

If OWWO: old well info as follows:
Operator.....
Well Name.....
Comp Date..... Old Total Depth.....

I certify that well will comply with K.S.A. 55-101, et seq., plus eventually plugging hole to KCC specifications.
Date..... **3/9/87** Signature of Operator or Agent *[Signature]* Title..... **AS. AGENT**

For KCC Use:


Conductor Pipe Required..... feet; Minimum Surface Pipe Required..... **20** feet per Alt. **40**
This Authorization Expires..... **7-9-87** Approved By..... **3-8-87** *[Signature]*

Must be filed with the K.C.C. five (5) days prior to commencing well
This card void if drilling not started within six (6) months of date received by K.C.C.

Important procedures to follow:

1. Notify District office before setting surface casing.
2. Set surface casing by circulating cement to the top.
3. File completion forms ACO-1 with K.C.C. within 120 days of well spud date, following instructions on ACO-1, side 1, and including copies of wireline logs.
4. Notify District office 48 hours prior to old well workover or re-entry.
5. Prior to filing Intent, prepare a proposed plugging plan in case well is D & A, then obtain approval of plan when calling district office prior to setting surface pipe.
6. Submit plugging report (CP-4) to K.C.C. after plugging is completed.
7. Obtain an approved injection docket number before disposing of salt water.
8. Notify K.C.C. within 10 days when injection commences or terminates.
9. If an alternate 2 completion, cement in the production pipe from below any usable water to surface within 120 days of spud date.

A Regular Section of Land
1 Mile = 5,280 Ft.

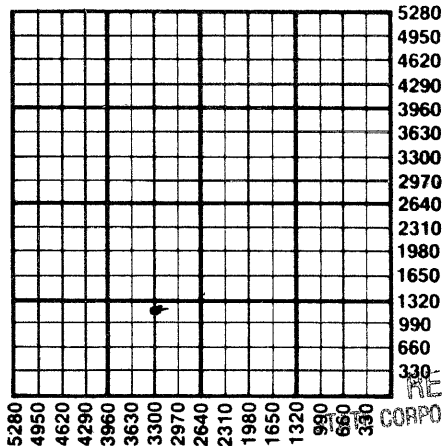

RECEIVED
CORPORATION COMMISSION
MAR 9 1987
03-09-87
CONSERVATION DIVISION
Wichita, Kansas

State Corporation Commission of Kansas
Conservation Division
200 Colorado Derby Building
Wichita, Kansas 67202-1212
(316) 263-3238