

CARD MUST BE TYPED

State of Kansas

CARD MUST BE SIGNED

NOTICE OF INTENTION TO DRILL

(see rules on reverse side)

✓0

Expected Spud Date.....12/11/87.....
month day year

API Number 15- 003-22,872-00-00

OPERATOR: License #6004.....

SE SW SW East
Sec 8..... Twp 21..... S, Rg 20..... West

NameCAIDWELL ENTERPRISES.....

165..... Ft. from South Line of Section

AddressBOX 42.....

4160..... Ft. from East Line of Section

City/State/ZipGARNETT.....66032.

(Note: Locate well on Section Plat on reverse side)

Contact Person.....GLENN CAIDWELL.....

Nearest lease or unit boundary line165..... feet

Phone.....(913) 448-3578.....

County.....Anderson.....

CONTRACTOR: License #5820.....

Lease Name.....Wilson..... Well #.....D-1.

NameKent Drilling.....

Ground surface elevation feet MSL

City/State.....Garnett, Kansas.....66032.....

Domestic well within 330 feet: _____ yes no

Well Drilled For: Well Class: Type Equipment:

Municipal well within one mile: _____ yes no

Oil _____ Storage Infield Mud Rotary

Depth to bottom of fresh water.....

_____ Gas _____ Inj. _____ Pool Ext. _____ Air Rotary

Depth to bottom of usable water 25.....

_____ OWWO _____ Expl _____ Wildcat _____ Cable

Surface pipe by Alternate: 1 _____ 2

If OWWO: old well info as follows:

Surface pipe planned to be set2.0.....

Operator

Conductor pipe required

Well Name

Projected Total Depth870..... feet

Comp Date..... Old Total Depth.....

Formation.....Squirrel.....

I certify that well will comply with K.S.A. 55-101, et seq., plus eventually plugging hole to KCC specifications.

Date Signature of Operator or Agent Greg Engler Title Agent.....

For KCC Use:

Conductor Pipe Required feet; Minimum Surface Pipe Required20 feet per Alt. X(2)

This Authorization Expires 6-10-88 Approved By PCH 12-10-87


EFFECTIVE DATE: 12-15-87

Must be filed with the K.C.C. five (5) days prior to commencing well
This card void if drilling not started within six (6) months of date received by K.C.C.

Important procedures to follow:

1. Notify District office before setting surface casing.
2. Set surface casing by circulating cement to the top.
3. File completion forms ACO-1 with K.C.C. within 120 days of well spud date, following instructions on ACO-1, side 1, and including copies of wireline logs.
4. Notify District office 48 hours prior to old well workover or re-entry.
5. Prior to filing Intent, prepare a proposed plugging plan in case well is D & A, then obtain approval of plan when calling district office prior to setting surface pipe.
6. Submit plugging report (CP-4) to K.C.C. after plugging is completed.
7. Obtain an approved injection docket number before disposing of salt water.
8. Notify K.C.C. within 10 days when injection commences or terminates.
9. If an alternate 2 completion, cement in the production pipe from below any usable water to surface within 120 days of spud date.

A Regular Section of Land 1 Mile = 5,280 Ft.

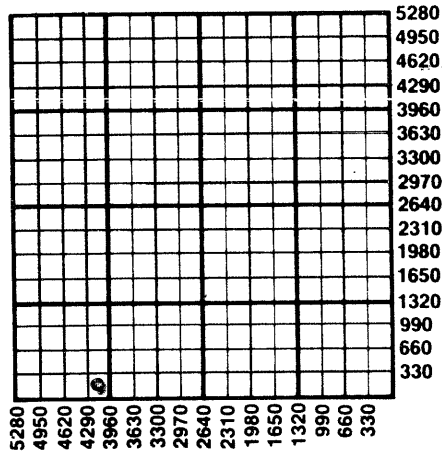

State Corporation Commission of Kansas
Conservation Division
200 Colorado Derby Building
Wichita, Kansas 67202-1212
(316) 263-3238